

GRA



Proposed

TRACT B

WK 5

A


B

A

C

D

BLOCK 9

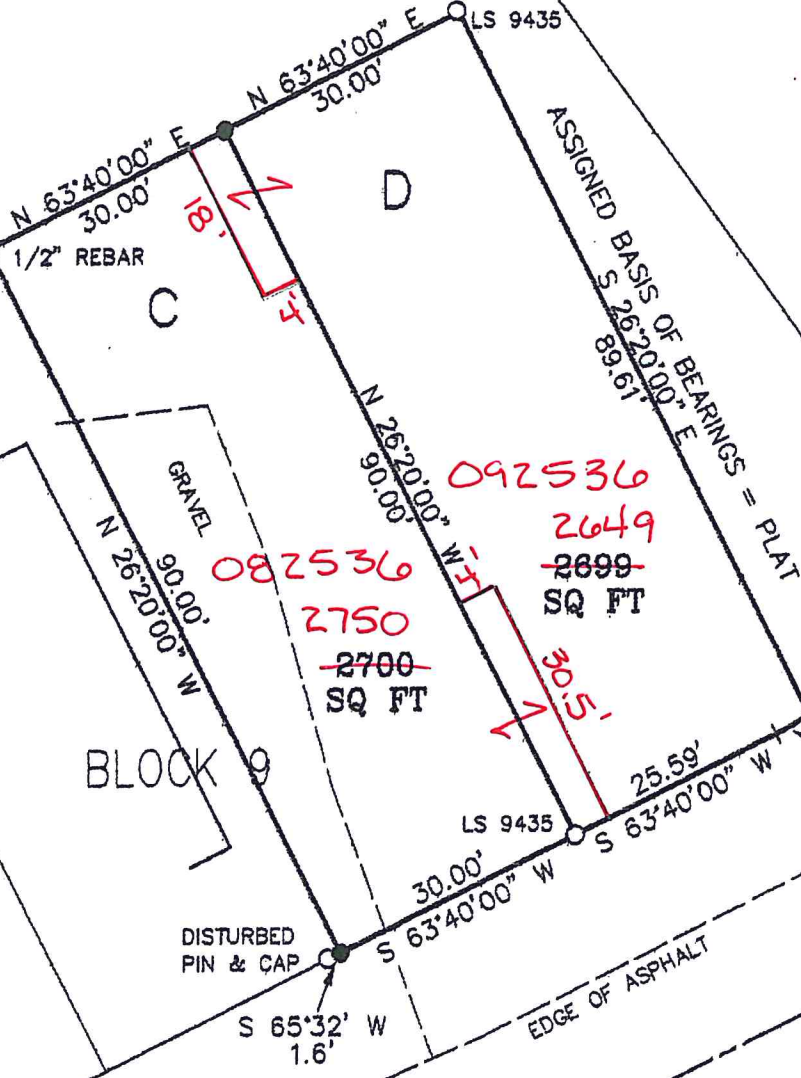

ASSIGNED BASIS OF BEARINGS = PLAT  
 S 26°20'00" E  
 89.61'

092536  
 2649  
~~2899~~  
 SQ FT

082536  
 2750  
~~2700~~  
 SQ FT

R=25.00'  
 L=4.43'  
 D=10°09'03"


DISTURBED  
 PIN & CAP

EDGE OF ASPHALT

S 63°40'00" W  
 C/L GUYE PEAK LANE

30.

30.

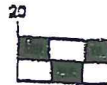

Proposed


TRACT B

K 5

A

B

A

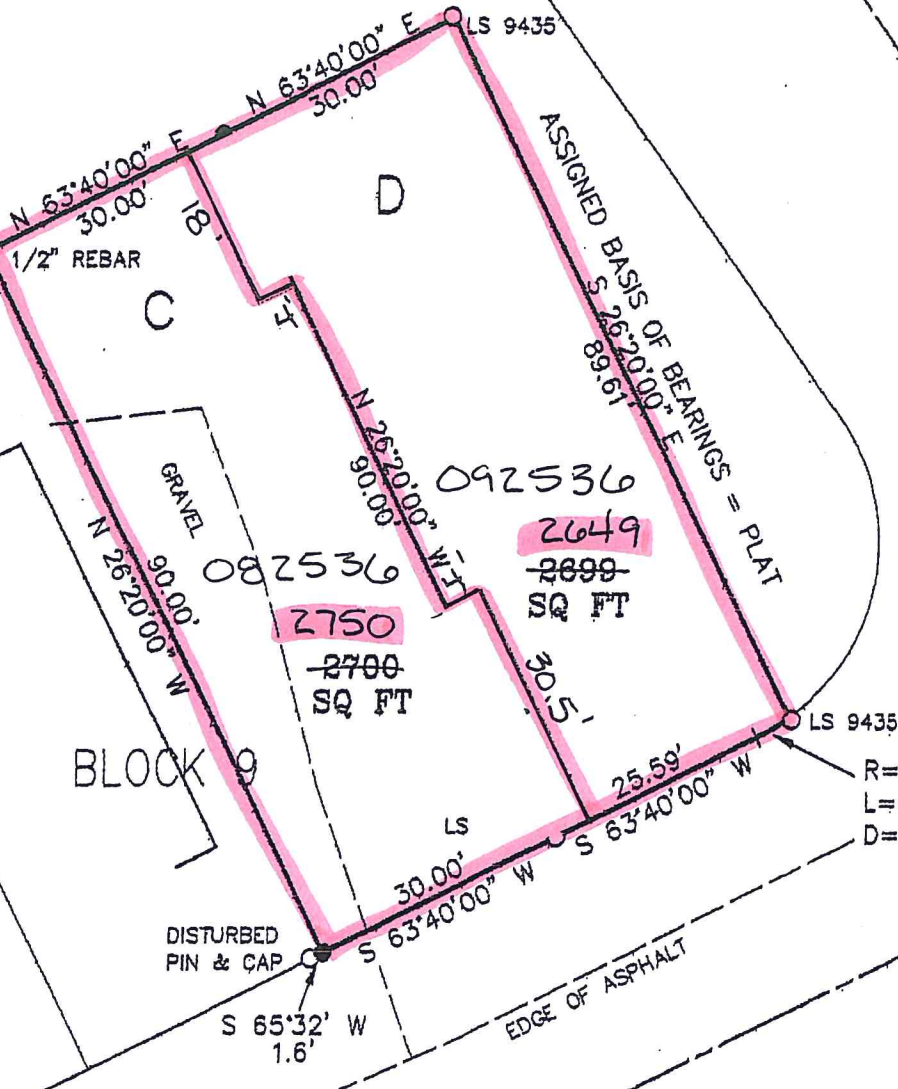

BLOCK 9

DISTURBED PIN & CAP


EDGE OF ASPHALT

S 63°40'00" W  
C/L GUYE PEAK LANE

30'

30'

Narrative - BLA is to adjust for Building setbacks as shown hereon.

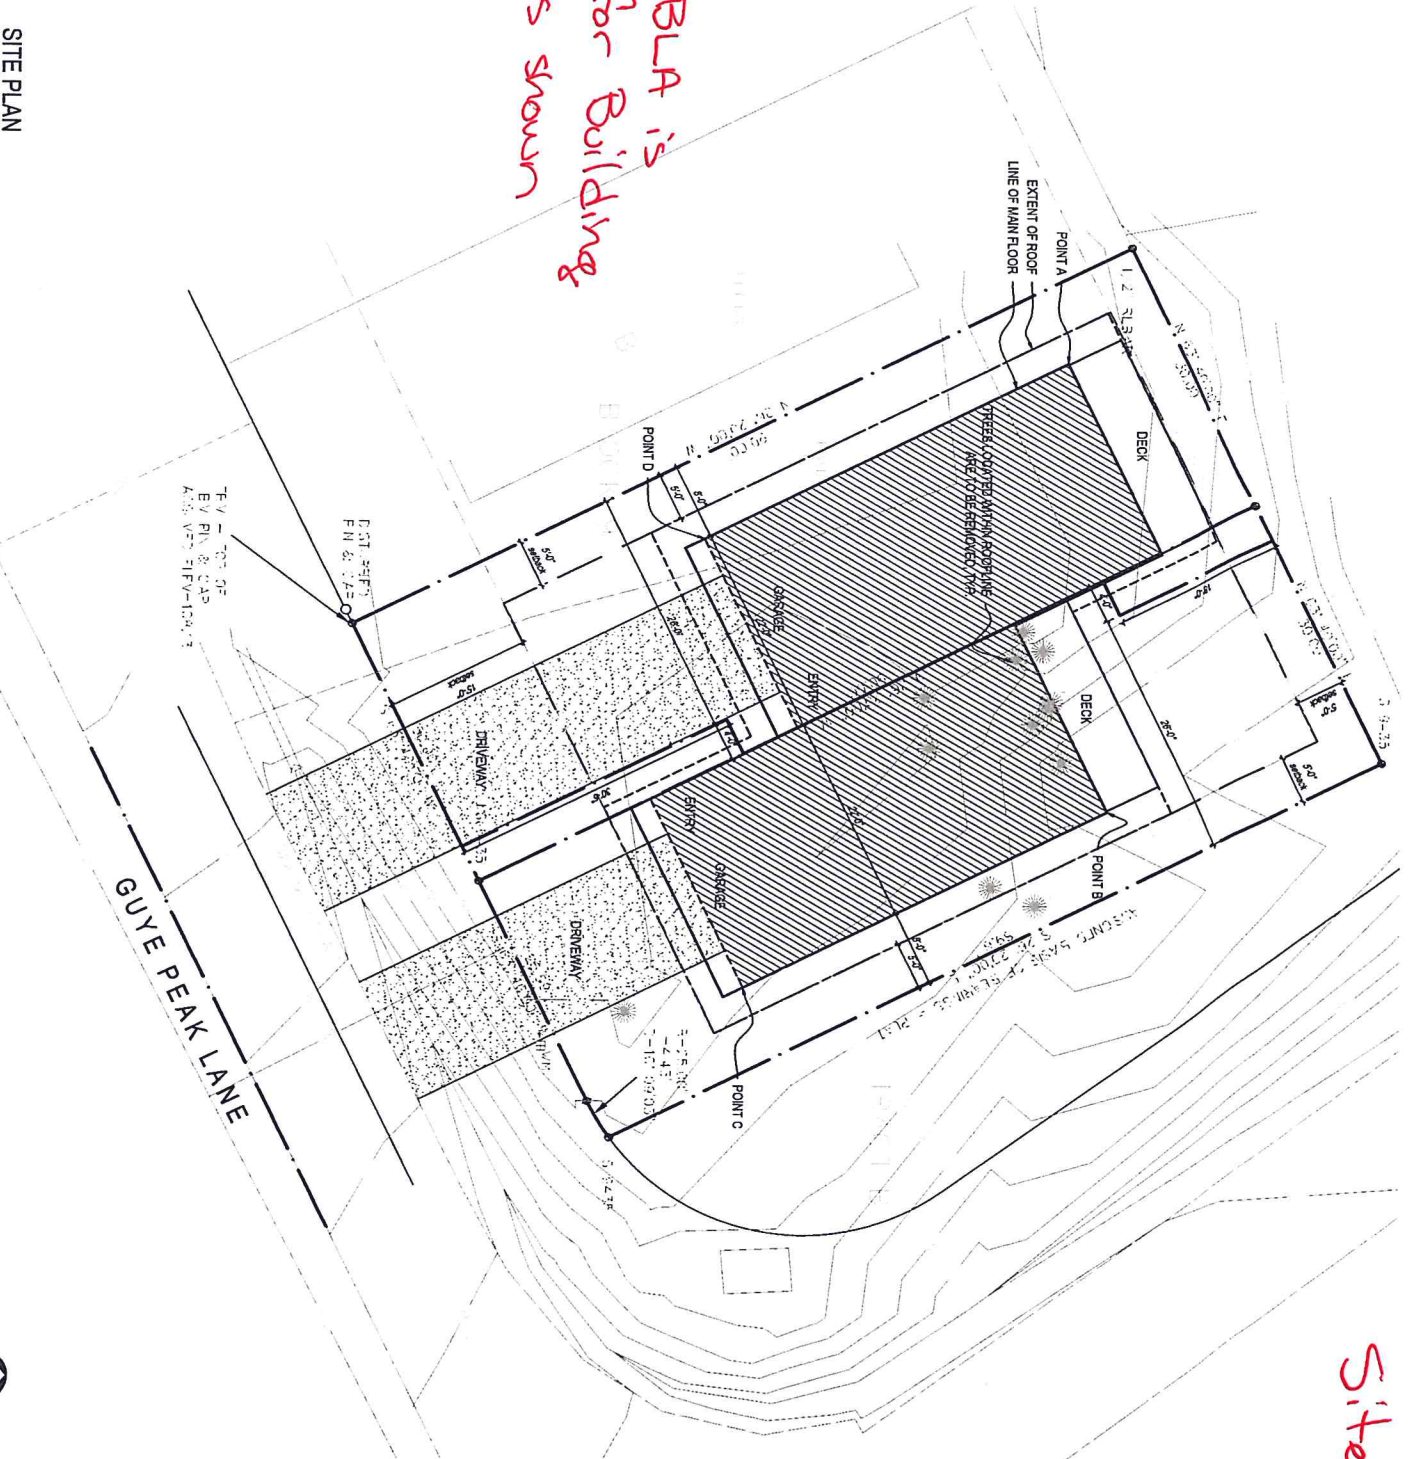

SITE PLAN

SCALE 1" = 10'-0"

Site Plan

