

SCALE 1" = 10'

| | | |
|-------|--------------------------------------|-----|
| 28-82 | REVISED INLET RUBBLE DETAIL AS BUILT | DML |
| 28-82 | ADDED STOCK PANEL DETAILS | DML |
| DATE | REVISION | BY |

KITTITAS COUNTY DEPARTMENT OF PUBLIC WORKS

KITTITAS COUNTY
ELENSBURG, WASHINGTON
BRICKMILL RD - ARCH PIPE
REPLACE BRIDGE # 89191
WILSON CREEK


SCALE: H AS SHOWN CRP 40-82 (Work Order No. 01162)

DRAWN BY [Signature] DATE 1981 SHEET 1 OF 1

APPROVED: [Signature] DATE 1-28-82 DIRECTOR OF PUBLIC WORKS




AS BUILT PLANS

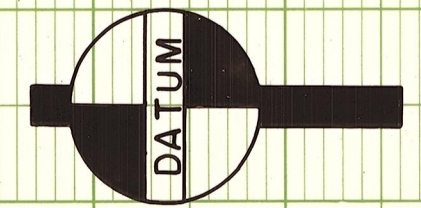


ELEV. ASSUMED

110
100
90

STA 3+12 ROAD
PROFILE EL = 101.10

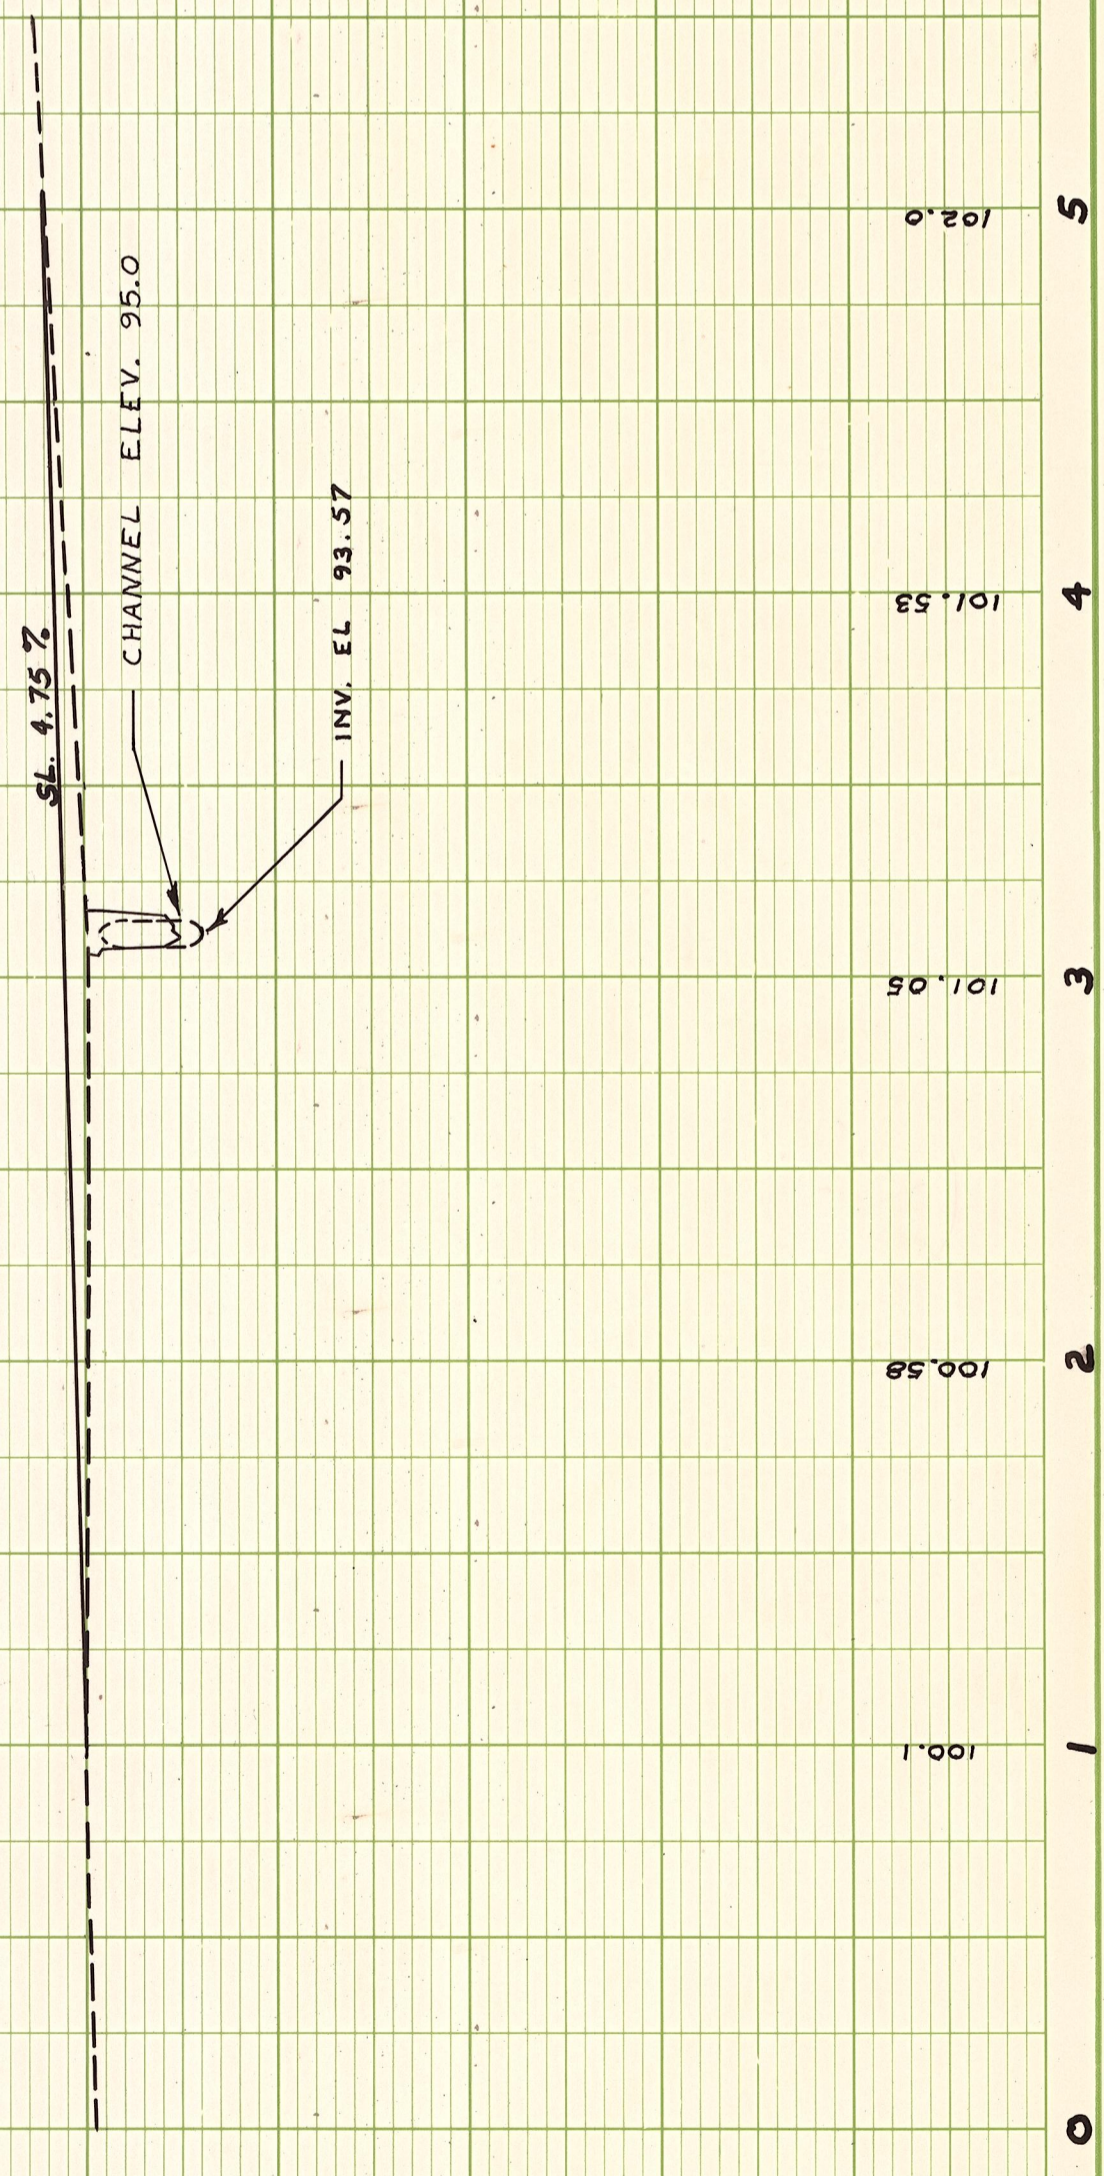

Note: Existing wood bridge to be removed

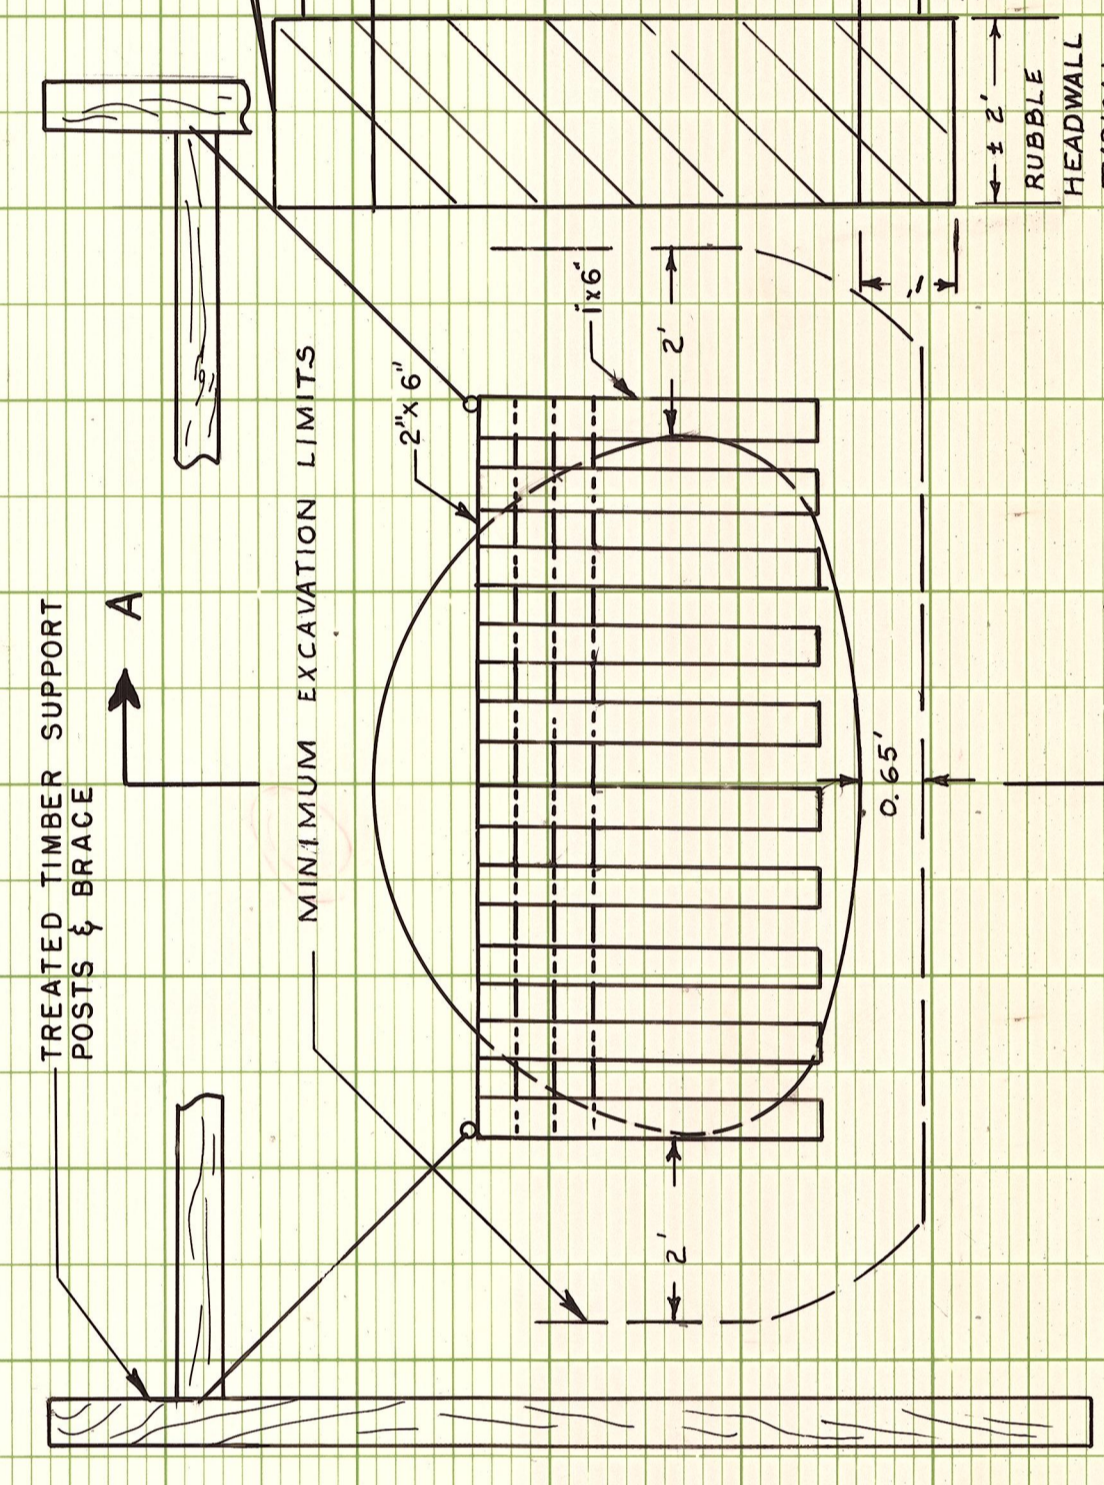

OUTLET END ELEVATION

VIEW A-A
NO SCALE

40' x 87' x 63' Arch C.M.P.
12 ga. Min.

GRAVEL FOR PIPE BEDDING 0.65' DEPTH

RUBBLE HEADWALL TYPICAL

| | |
|--------------------|------|
| PLAN | |
| SURVEYED | BY |
| NOTED | DATE |
| ALIGNED | |
| CHECKED | |
| BY OR W/AV CHECKED | |
| NO. | |

| | |
|--------------------|------|
| PROFILE | |
| SURVEYED | BY |
| NOTED | DATE |
| ALIGNED | |
| CHECKED | |
| BY OR W/AV CHECKED | |
| NO. | |