


PDF Complete ranked PC World 2021 Best Budget PDF Editor  
Extend the lifetime of your PDF software and get more features.  
Purchase PDF Complete Office Edition to upgrade to editing, scanning, and OCR!

Best Budget PDF Editor

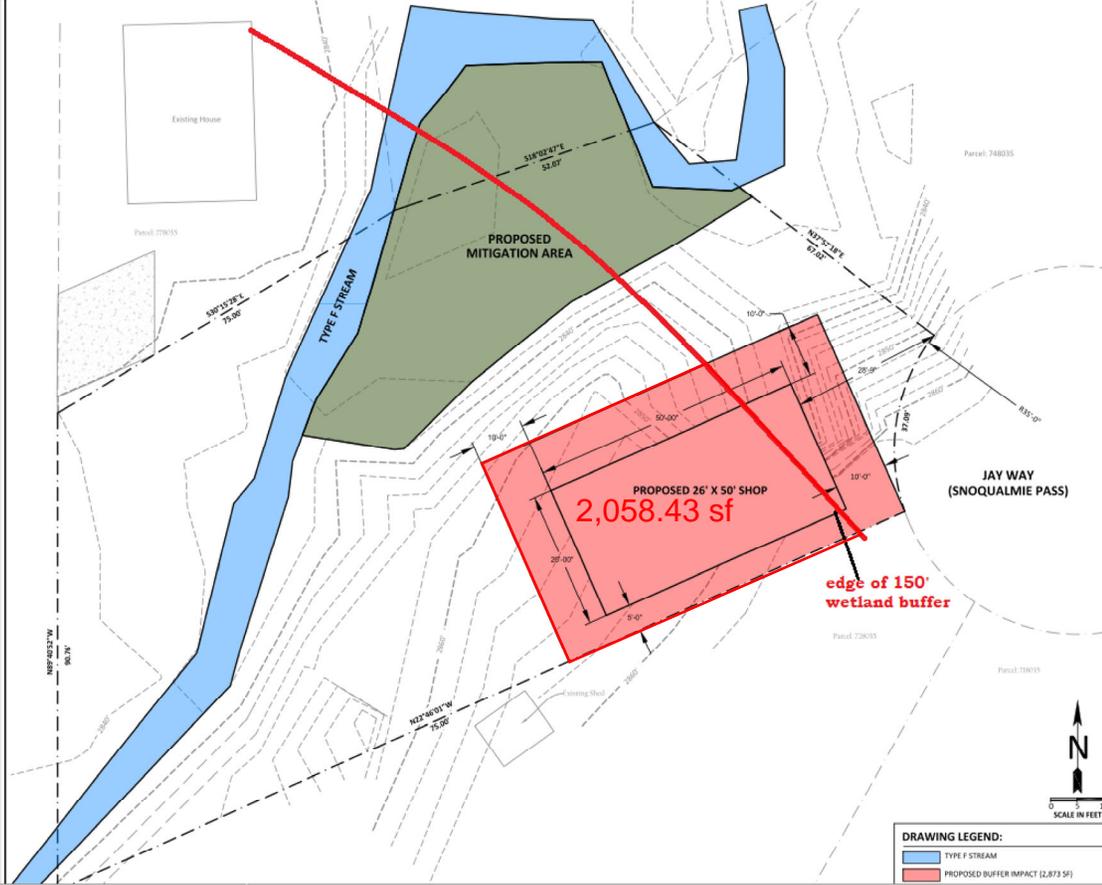

**MONITORING PLAN:**

THE 5 YEAR MONITORING PLAN OUTLINED BELOW WILL ENSURE AND DOCUMENT THAT THE PERFORMANCE STANDARDS ESTABLISHED FOR THIS PLAN HAVE BEEN MET. THE LOT OWNER IS RESPONSIBLE FOR SUCCESSFUL COMPLETION OF THE WORK DESCRIBED ON THIS PLAN. IF THE PROPERTY IS SOLD OR PROPERTY OWNERSHIP IS OTHERWISE TRANSFERRED, RESPONSIBILITY FOR ANY REMAINING WORK SHALL BE TRANSFERRED TO THE NEW OWNER AND RECORDED WITH KITITAS COUNTY.

**PLAN GOALS, OBJECTIVES, AND PERFORMANCE STANDARDS**

MITIGATION PLAN GOALS, MONITORING SCHEDULE, AND PERFORMANCE STANDARDS ARE OUTLINED BELOW. THE GOALS OF THIS PLAN ARE CONSIDERED ACHIEVED WHEN THE PERFORMANCE STANDARDS ARE SATISFIED.

**GOAL #1 - RESTORE/ENHANCE ON-SITE STREAM BUFFER**

**OBJECTIVE #1 - INSTALL NATIVE PLANTINGS WITHIN THE BUFFER AREAS SHOWN ON THIS DRAWING**

**PERFORMANCE STANDARD #1 - PLANT SURVIVAL**

YEAR 1 - 100% SURVIVAL  
YEAR 2 THROUGH YEAR 5 - 85% SURVIVAL

THIS STANDARD CAN BE ACHIEVED THROUGH PLANT ESTABLISHMENT OR THROUGH PLANT REPLACEMENT.

**AS-BUILT**

FOLLOWING COMPLETION OF THE WORK SHOWN ON THIS PLAN, A QUALIFIED PROFESSIONAL SHALL PREPARE AN AS-BUILT OF THE COMPLETED WORK. THE AS-BUILT SHALL SUMMARIZE THE COMPLETED WORK AS WELL AS ANY DEVIATIONS FROM THE APPROVED VERSION OF THIS PLAN. THE AS-BUILT SHALL BE SUBMITTED TO KITITAS COUNTY NO LATER THAN 30 DAYS FROM THE DATE THAT THE WORK IS COMPLETED ON THIS PLAN HAS BEEN COMPLETED.

**ANNUAL MONITORING (5 YEARS)**

ANNUAL MONITORING SHALL BE COMPLETED FOR A PERIOD OF FIVE (5) YEARS, UNLESS OTHERWISE ALLOWED BY KITITAS COUNTY. ANNUAL MONITORING SHALL BE COMPLETED BY A QUALIFIED PROFESSIONAL AND SHALL COMPRISE A SITE INVESTIGATION IN AUGUST OR SEPTEMBER AND REPORTING TO KITITAS COUNTY NO LATER THAN 30 DAYS FOLLOWING EACH MONITORING.

THE PURPOSE OF THE SITE INVESTIGATION IS TO EVALUATE CONDITIONS WITHIN THE PLANTING AREAS PER THE CURRENT YEAR'S PERFORMANCE STANDARDS. THE FOLLOWING INFORMATION SHALL BE COLLECTED AND ASSESSED RELATIVE TO THE PERFORMANCE STANDARDS ESTABLISHED FOR THE PROJECT:

- PERCENT SURVIVAL. A DIRECT COUNT INVENTORY AND ASSESSMENT OF ALL INSTALLED PLANTS SHALL BE USED TO EVALUATE PERCENT SURVIVAL. THE RATIONALE FOR POOR CONDITIONS, IF PRESENT, WILL BE DETERMINED TO THE EXTENT FEASIBLE.

IN ADDITION TO THE ABOVE INFORMATION, PHOTOGRAPHS SHALL BE TAKEN FROM THE PERMANENT PHOTO POINTS ESTABLISHED DURING THE AS-BUILT.

THE RESULTS OF EACH MONITORING ASSESSMENT SHALL BE SUMMARIZED IN A WRITTEN REPORT AND SUBMITTED TO KITITAS COUNTY NO LATER THAN 30 DAYS FOLLOWING EACH MONITORING.

**MAINTENANCE PLAN:**


INSTALLED PLANTS SHALL BE MAINTAINED AT REGULAR INTERVALS DURING THE MONITORING PERIOD TO PROMOTE THE SUCCESSFUL ESTABLISHMENT AND VIGOROUS GROWTH OF THE INSTALLED PLANT STOCK. GENERAL MAINTENANCE SHALL INCLUDE:

- RE-APPLYING BARK MULCH TO MAINTAIN A 6" MINIMUM APPLIED THICKNESS - YEAR 1 ONLY.
- THE PRUNING OF INSTALLED PLANTS TO REMOVE DEAD WOOD AND PROMOTE VIGOROUS PLANT GROWTH AND PROPER FORM.
- THE REPLACEMENT OF PLANTS THAT APPEAR TO BE IN DISTRESS AND/OR DISEASED.
- THE REMOVAL OF TRASH, LITTER, AND/OR OTHER NON-DECOMPOSING DEBRIS.

GENERAL MAINTENANCE WORK SHALL OCCUR MONTHLY DURING THE GROWING SEASON AND/OR AT A FREQUENCY OTHERWISE NECESSARY TO ENSURE THE SUCCESSFUL ESTABLISHMENT AND VIGOROUS GROWTH OF THE INSTALLED PLANTS.

**CONTINGENCY PLAN:**

SHOULD ANY MONITORING ASSESSMENT REVEAL THAT THE PERFORMANCE STANDARDS FOR THE RESPECTIVE YEAR ARE NOT SATISFIED, THE PERMITTEE SHALL WORK WITH KITITAS COUNTY TO DEVELOP A CONTINGENCY PLAN TO ADDRESS THE DEFICIENCIES. CONTINGENCY PLANS CAN INCLUDE, BUT ARE NOT LIMITED TO, THE FOLLOWING ACTIONS: 1) ADDITIONAL PLANT INSTALLATION; 2) ZONE CONTROL; 3) HERBIVORY PROTECTION; 4) MODIFICATION TO THE IRRIGATION REGIME; AND/OR 5) PLANT SUBSTITUTIONS OF TYPE, SIZE, QUANTITY, AND LOCATION. SUCH CONTINGENCY PLAN SHALL BE SUBMITTED TO KITITAS COUNTY WITHIN 30 DAYS OF WHEN DEFICIENCIES ARE DISCOVERED. UNLESS OTHERWISE APPROVED BY KITITAS COUNTY, ACTIONS SPECIFIED ON AN APPROVED CONTINGENCY PLAN MUST BE COMPLETED WITHIN 60 DAYS. IF THE FAILURE IS SUBSTANTIAL, KITITAS COUNTY MAY EXTEND THE COMPLIANCE MONITORING PERIOD FOR THE ENHANCEMENT WORK.

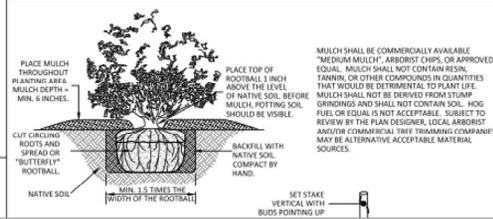

**Sewall Wetland Consulting, Inc.**  
PO Box 888 - Fall City, Washington 98024 Phone: 253-859-0515

**CRITICAL AREA MITIGATION PLAN**  
- PROPOSED IMMER SHOP -

101 JAY WAY - SNOQUALMIE PASS, WASHINGTON  
KITITAS COUNTY PARCEL ID 738035

**811**  
Know what's below.  
Call before you dig.