

T.20N., R.14 E., W.M.

SEC. 26

STA 233+52.23 P.O.T.
BEGINNING OF PROJECT

NELSON SIDING 1
RECORDED IN VOL. 5, PAGES 42 & 43
RECORDS OF KITTITAS COUNTY, WA.
RECORDING NO. 356594


UNPLATTED

A 44+23.13
P.T. = 20+39.03
P.C. = 113+20.5
P.I. = 221+20.5
R = 244+4.67
R = 21525.18

LAUREL SPRINGS
RECORDED IN VOL. 5 OF PLATS, PAGE 26
RECORDS OF KITTITAS COUNTY, WA.
RECORDING NO. 355254

FOUND D.N.R. 26 34 35
BRASS CAP

EAST NELSON ACRES
RECORDED IN VOL. 5 OF PLATS, PAGES 63, 64 & 65
RECORDS OF KITTITAS COUNTY, WA.
RECORDING NO. 365417

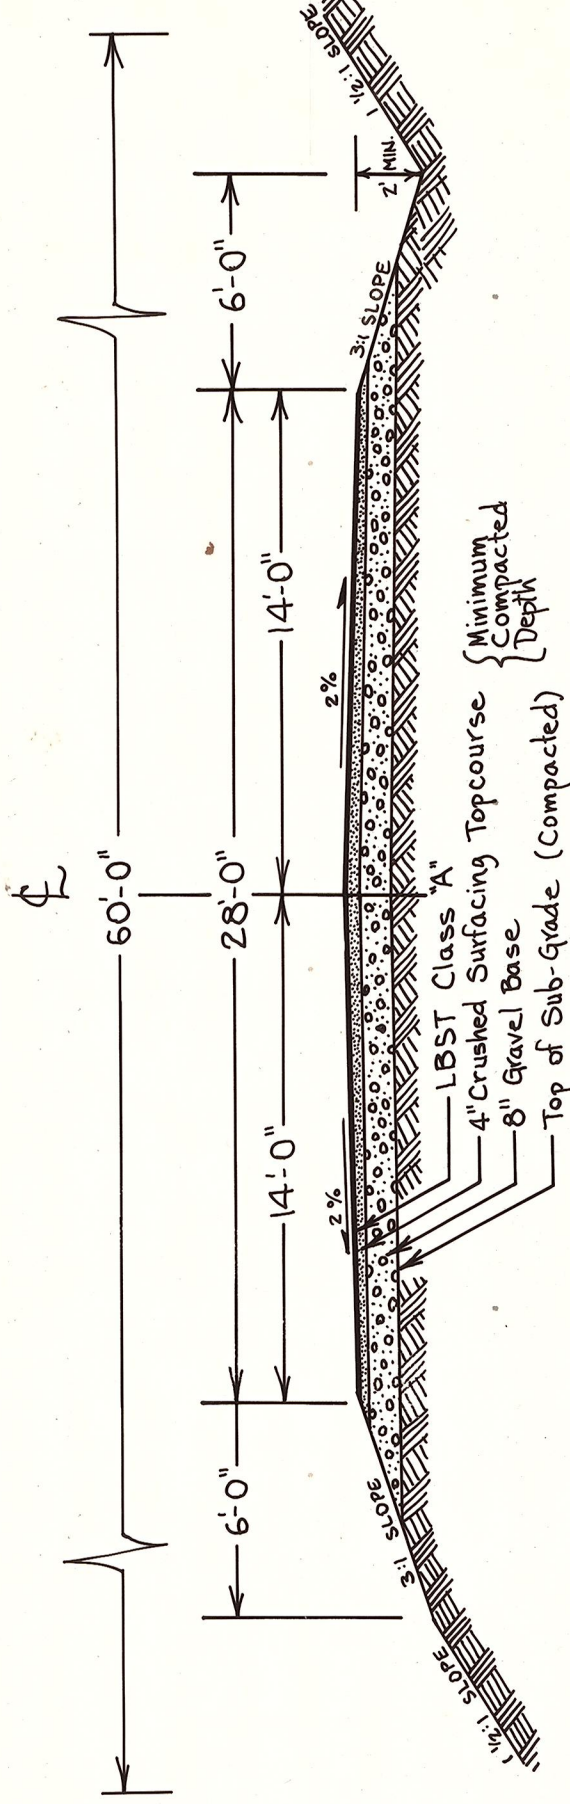

ROADWAY SECTION

AS BUILT DRAWING

DEPARTMENT OF PUBLIC WORKS

KITTITAS COUNTY
ELLENSBURG, WASHINGTON
NELSON SIDING ROAD

NO. 23030

LENGTH = 0.69 MI.


SCALE: H 1"=100'
V 1"=10'

DRAWN BY J.N. DATE JUNE 1989

SHEET 1 OF 2

APPROVED:

DATE _____ DIRECTOR OF PUBLIC WORKS

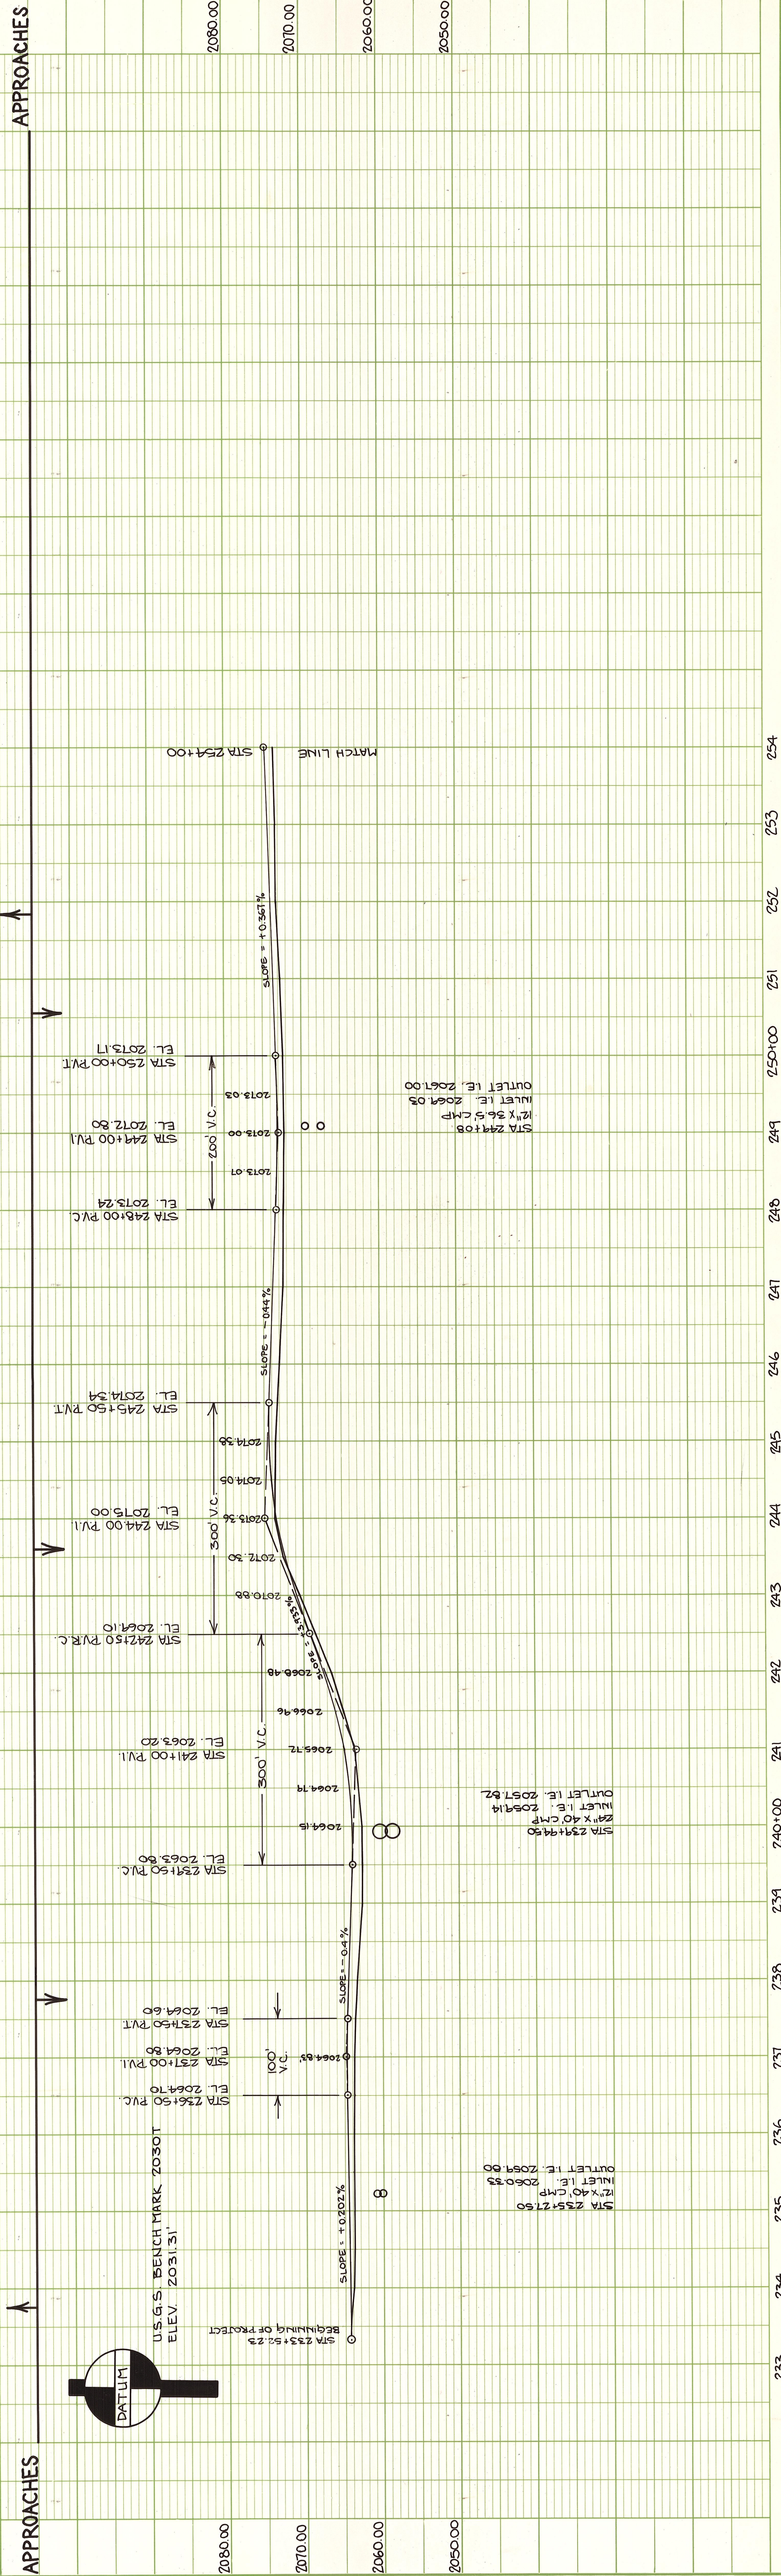

APPROACHES


APPROACHES

T.20N., R.14E., W.M.

LAUREL SPRINGS
RECORDED IN VOL. 5 OF PLATS, PAGE 26
RECORDS OF KITTITAS COUNTY, WA.
RECORDING NO. 355254

SEC. 26

UNPLATTED

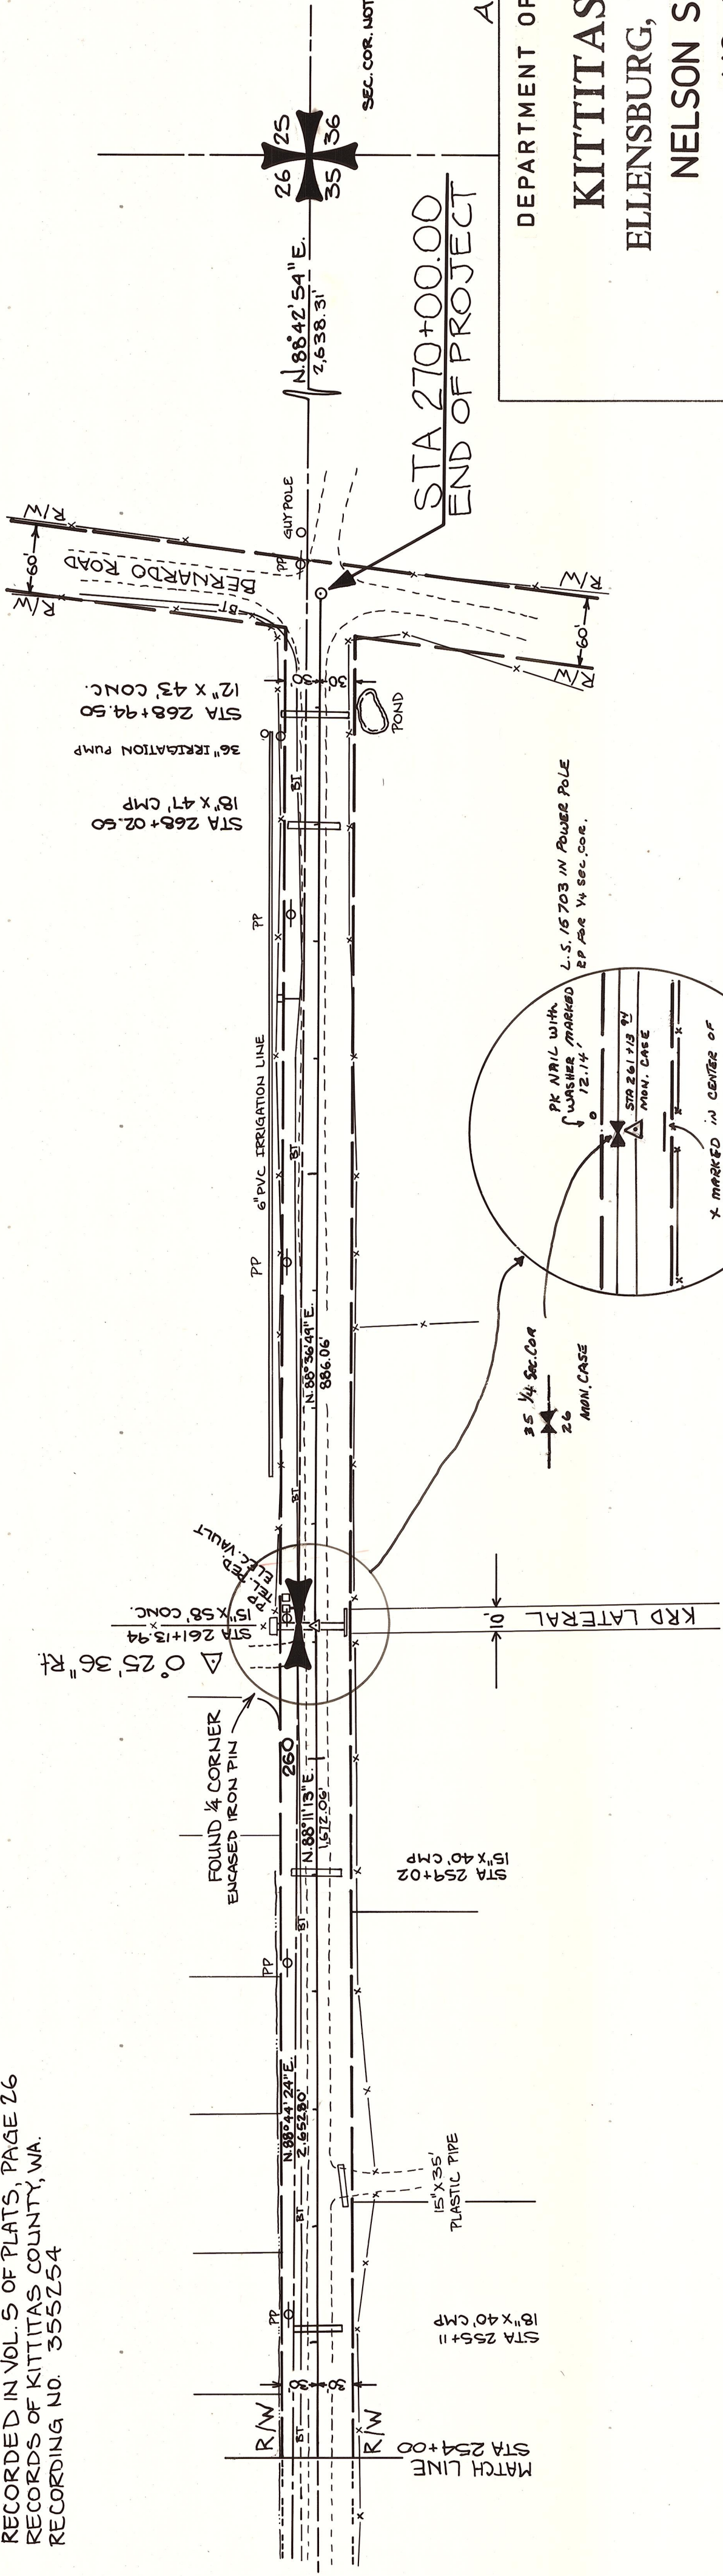

EAST NELSON ACRES
RECORDED IN VOL. 5 OF PLATS, PAGES 63, 64 & 65
RECORDS OF KITTITAS COUNTY, WA.
RECORDING NO. 365417

AS BUILT DRAWING

DEPARTMENT OF PUBLIC WORKS

KITTITAS COUNTY

ELENSBURG, WASHINGTON

NELSON SIDING ROAD

NO. 23030


LENGTH = 0.69 MI.

CR P

SCALE: H 1"=100'
V 1"=10'

DRAWN BY J.N. DATE JUNE 1989 SHEET 2 OF 2

APPROVED: _____ DATE _____ DIRECTOR OF PUBLIC WORKS

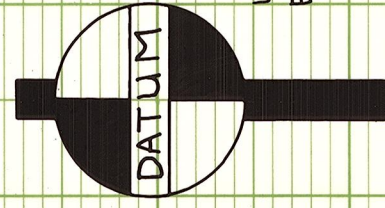

APPROACHES

APPROACHES

PROFILE	
NO. _____	STRUCTURE NOTATIONS CHECKED
SURVEYED _____	GRADES CHECKED
NOTED _____	R.M. & NOTED _____
BY _____	DATE _____

