

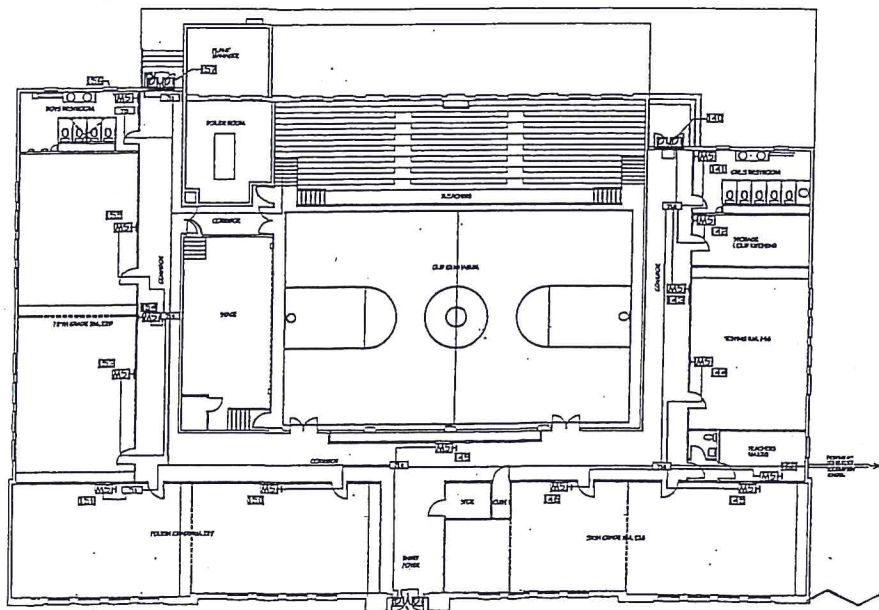
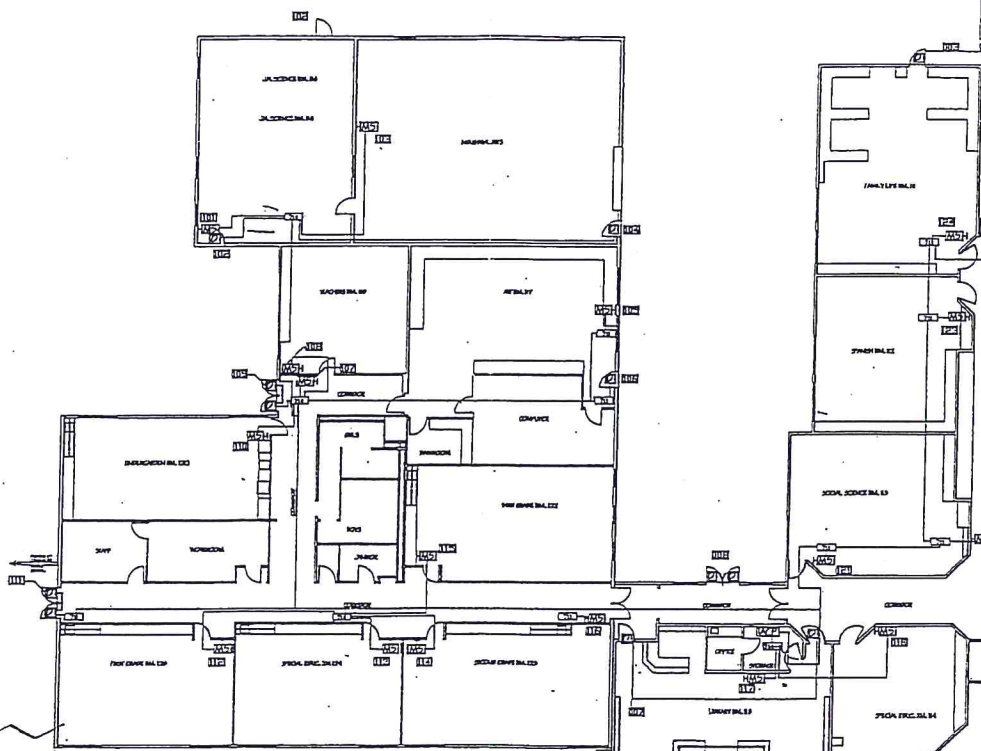


BOILER RM & OLD LOCKER RM
SCALE: 1/8" = 1'-0"

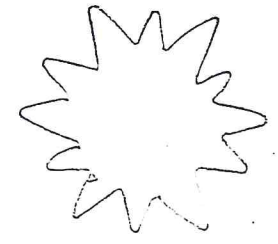


MIDDLE SCHOOL FLOOR PLAN
SCALE: 1/16" = 1'-0"

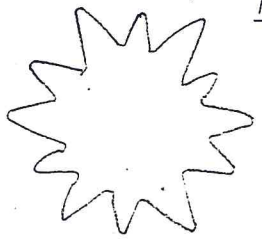


ELEMENTARY AND JR. HIGH FLOOR PLAN
SCALE: 1/16" = 1'-0"

existing sign

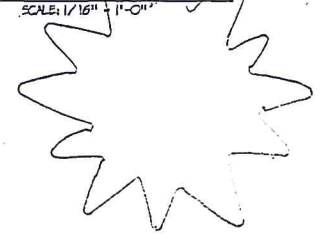

side walk

RECEIVED
MAY 22 2014
KITITAS COUNTY
CDS

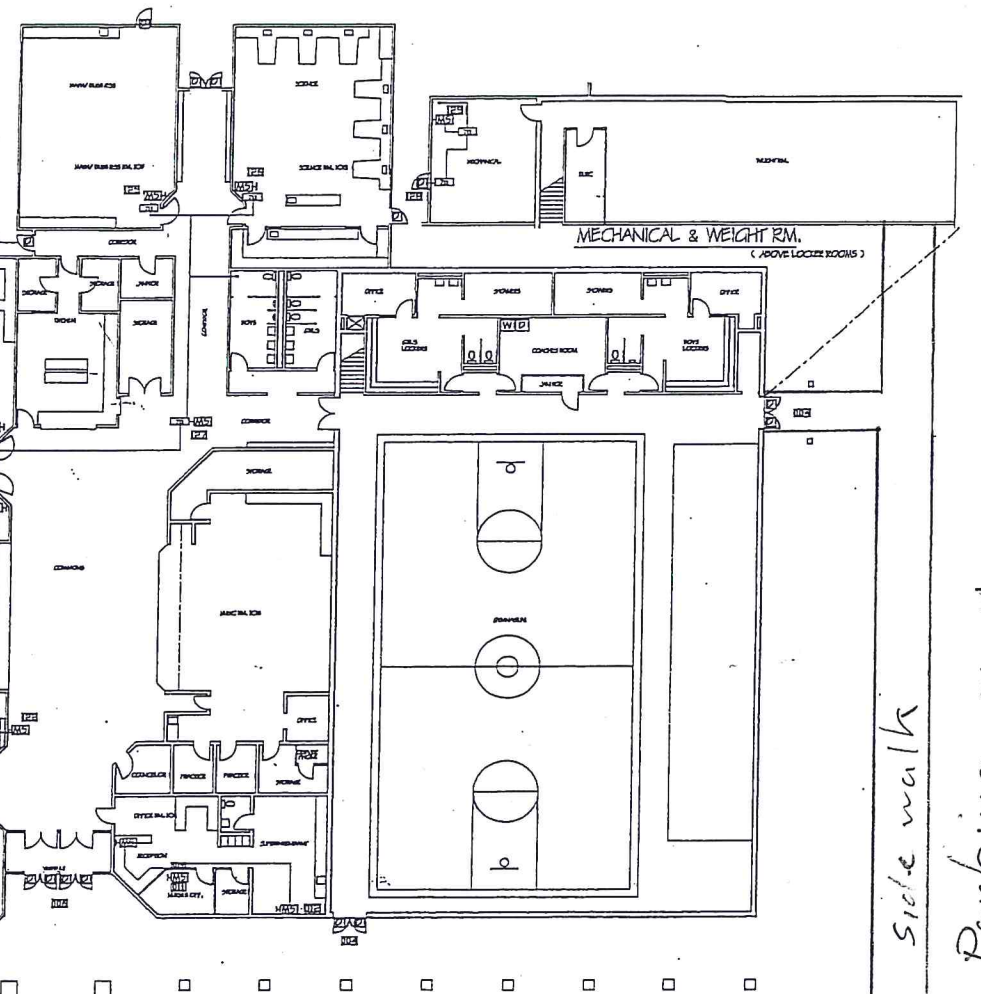


HIGH SCHOOL FLOOR PLAN
SCALE: 1/16" = 1'-0"

new sign location

Symbol Legend	
	Motion Sensor
	Door Contact
	Keypad Controller
	Addressable Input
	Device ID Number

side walk
parking area

North Thorp Hwy.

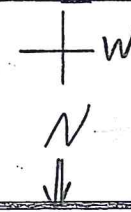

e³ Solutions, Inc.
P.O. Box 72
Yakima, WA 98907
November 26, 2003

Security Alarm System As-Built Drawing

Thorp Schools

Not to Scale