




B
8

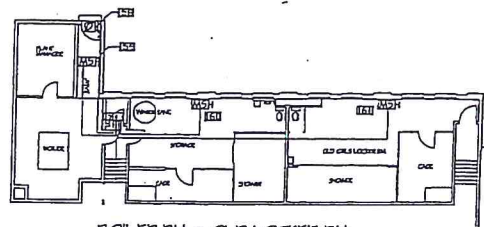


BOILER RM & OLD LOCKER RM
SCALE: 1/8" = 1'-0"

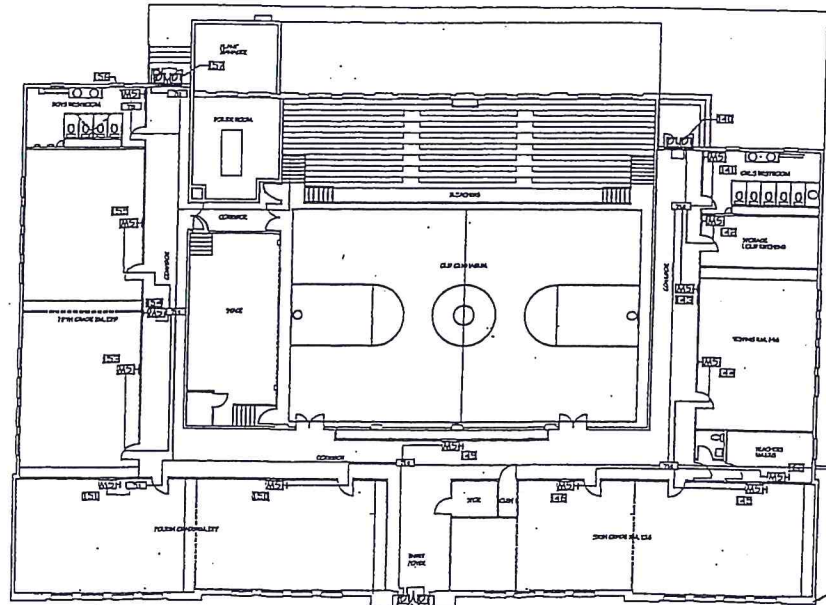




MIDDLE SCHOOL FLOOR PLAN
SCALE: 1/16" = 1'-0"

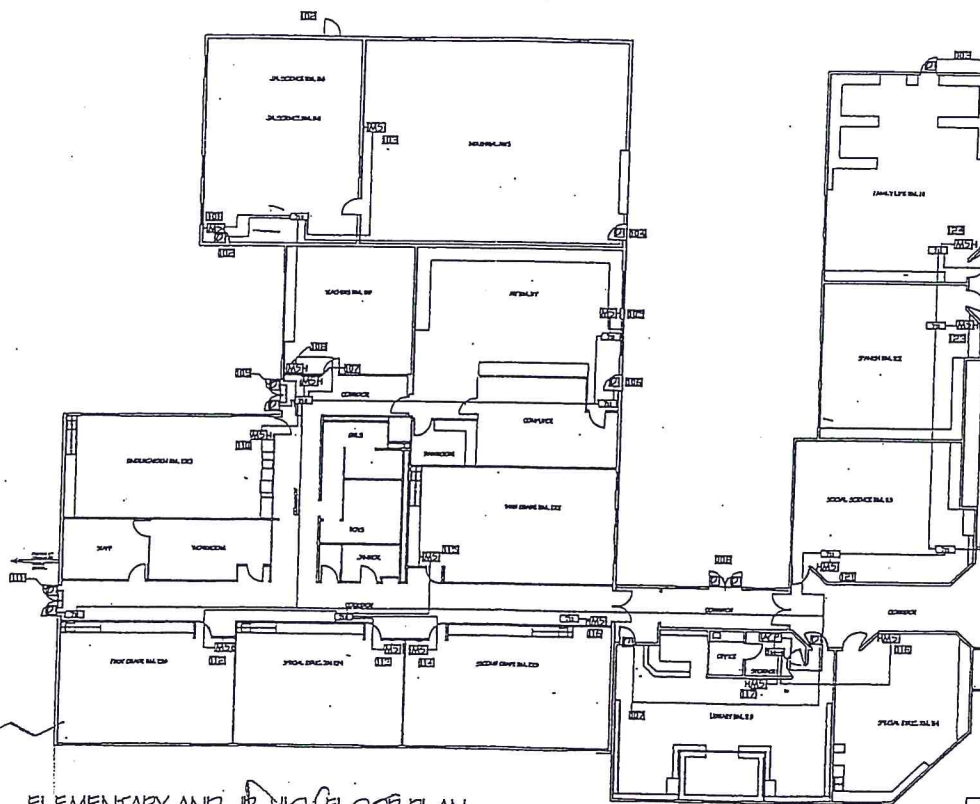

ELEMENTARY AND JR. HIGH FLOOR PLAN
SCALE: 1/16" = 1'-0"

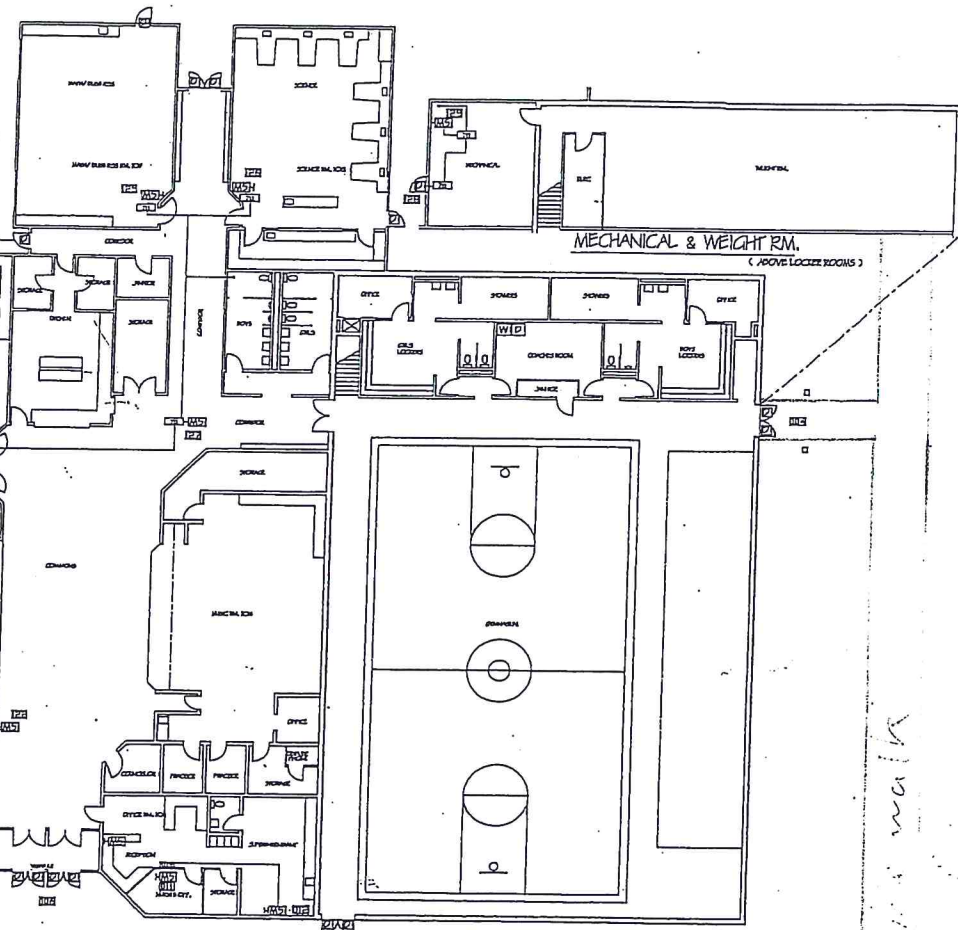

HIGH SCHOOL FLOOR PLAN
SCALE: 1/16" = 1'-0"

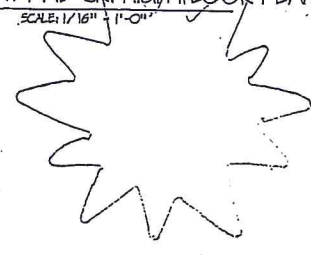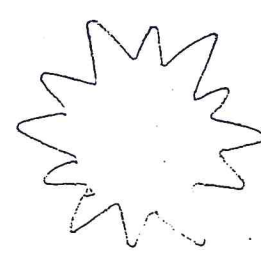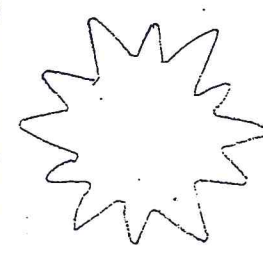

existing sign


side walks

RECEIVED
MAY 2 2014

new sign location

side walk
parking area

Symbol Legend	
	Motion Sensor
	Door Contact
	Keypad Controller
	Addressable Input
	Device ID Number

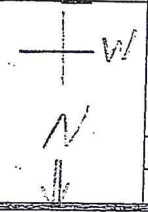

North Thorp Hwy.

e3 Solutions, Inc. P.O. Box 72 Yakima, WA 98907	Security Alarm System As-Built Drawing	
	Thorp Schools	
November 26, 2003	SCALE: Not To Scale	SHEET