




Irrigation Box
Sta 31+10
Box Q 25' Lt

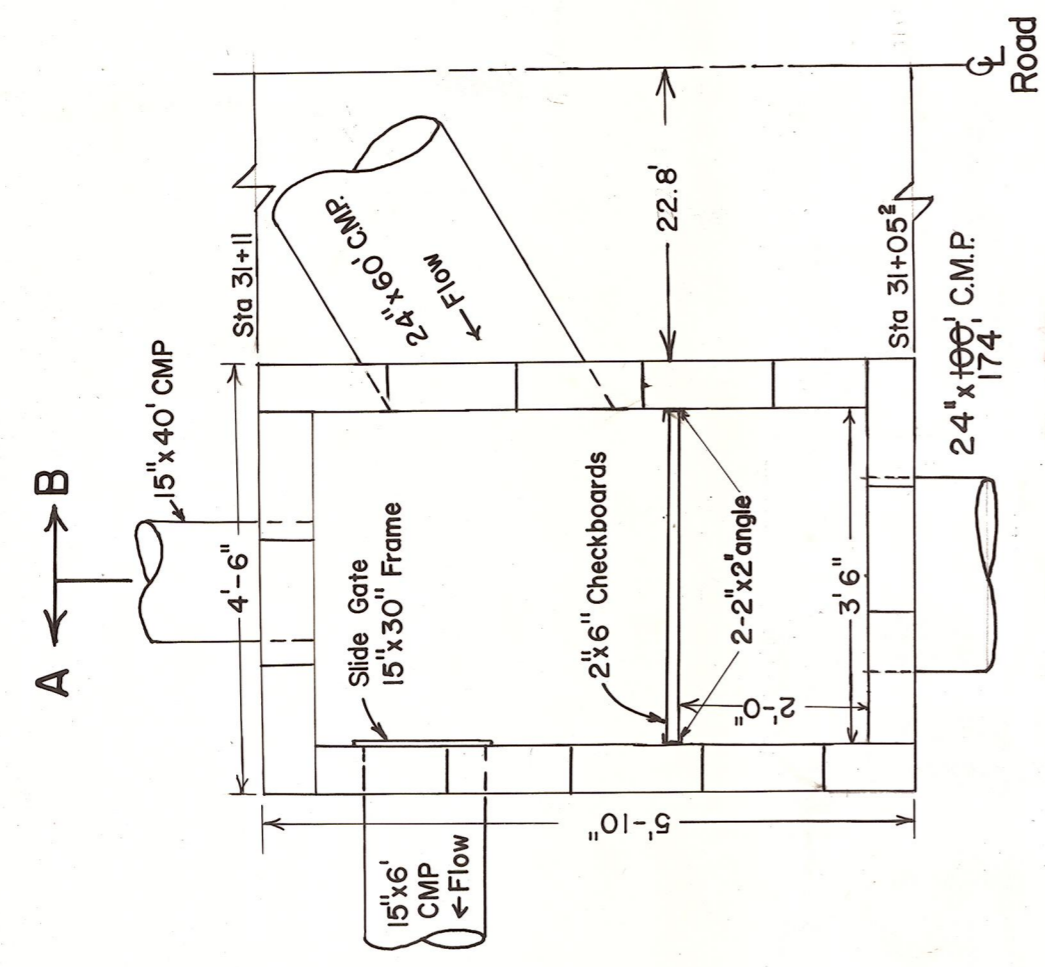

PLAN
Scale 1"=2'

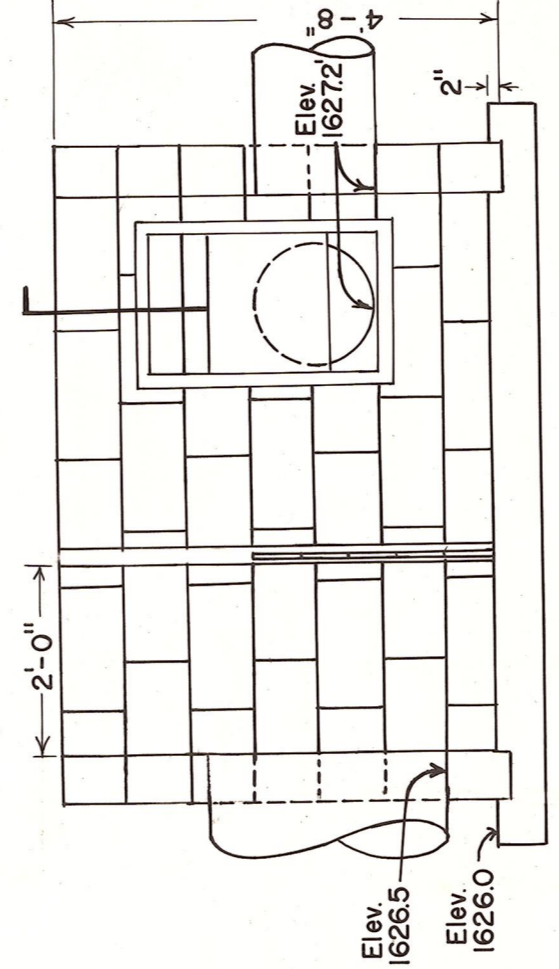


Section A-A

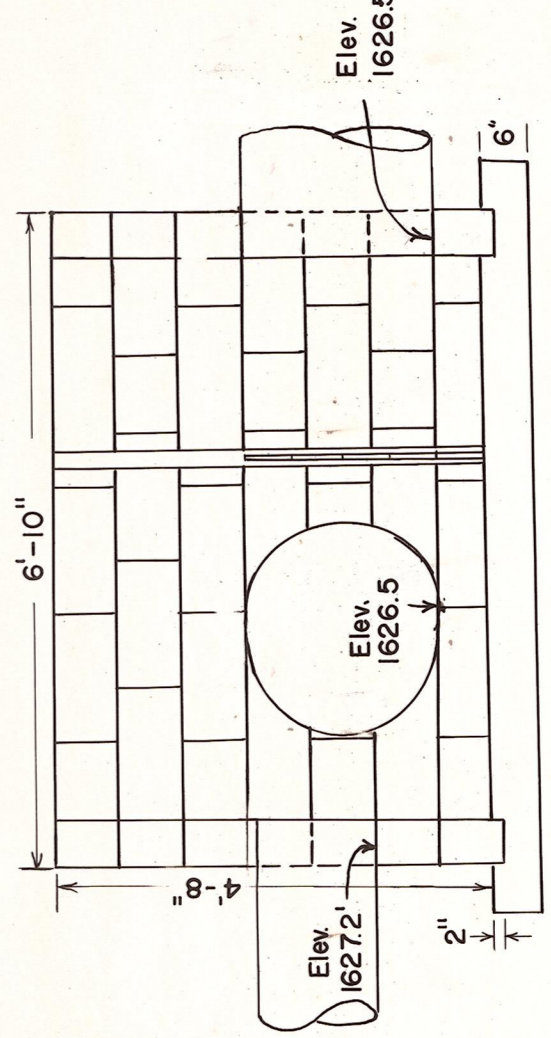


Section B-B


Irrigation Box
Sta 31+50
Box Q 22' Lt.

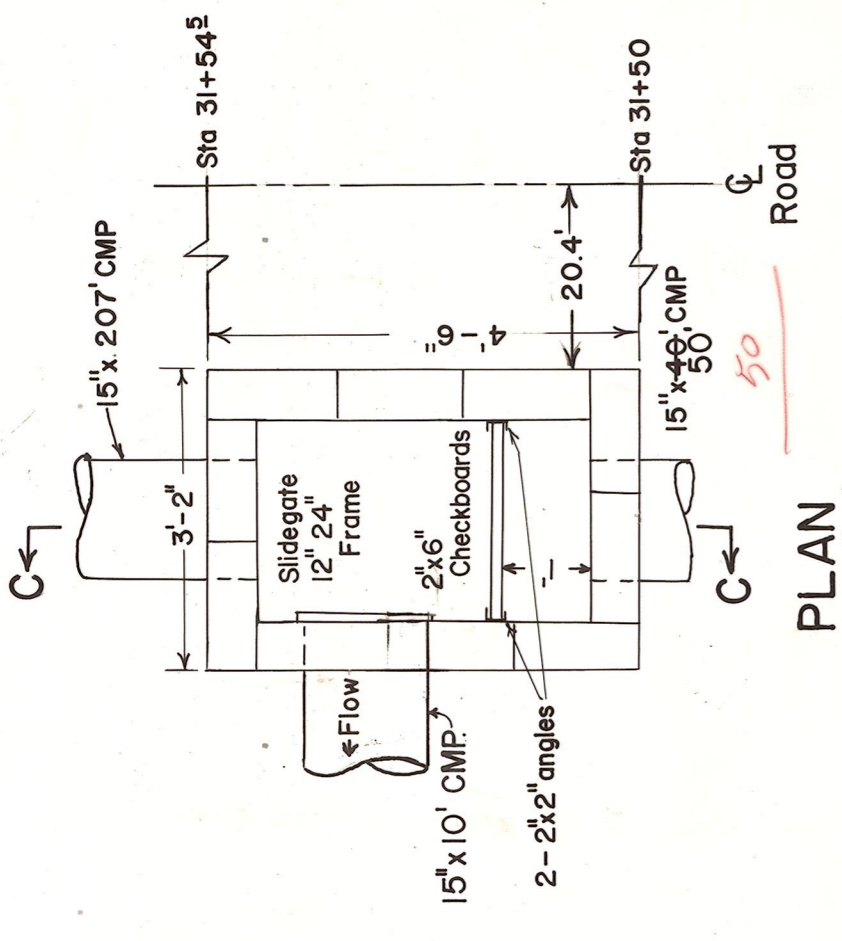


PLAN
Scale 1"=2'

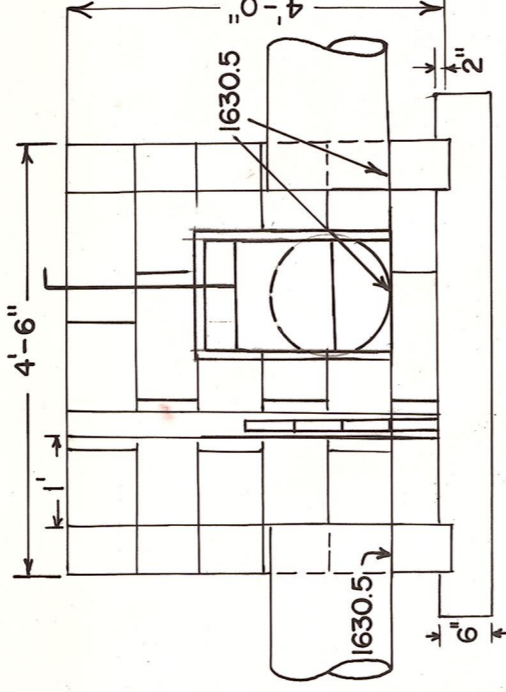

Section C-C
Scale 1"=2'

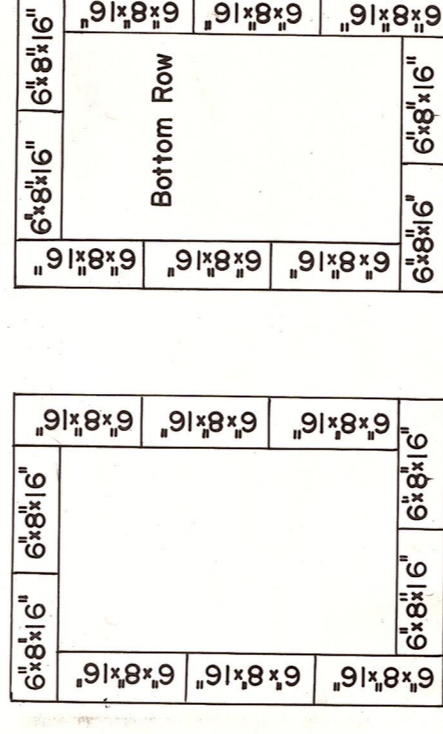


Block Placement Detail

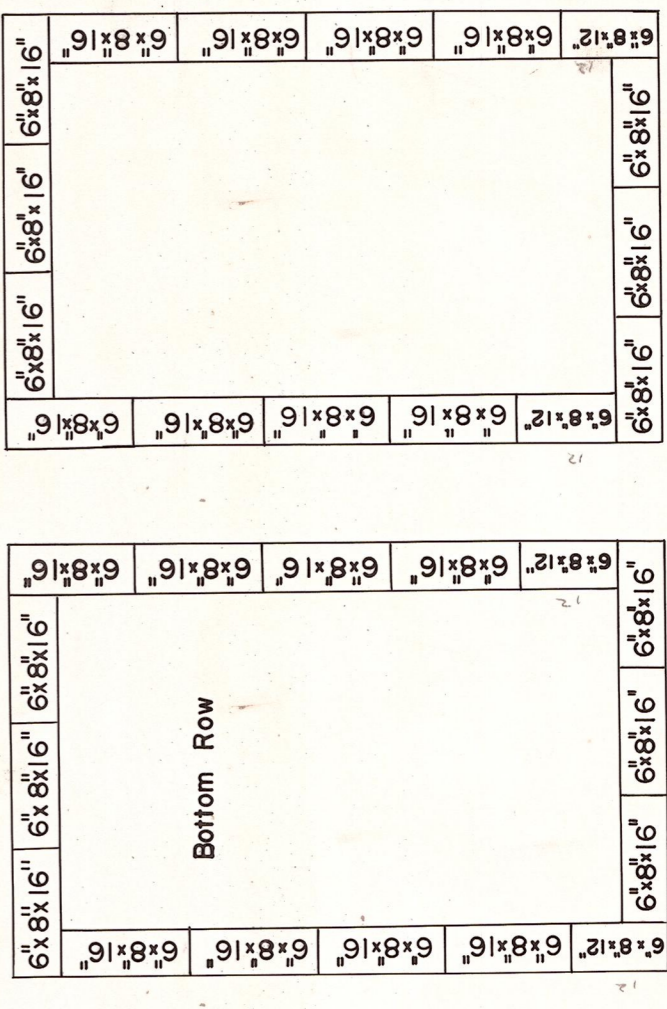


Block Placement Detail


Irrigation Box
Sta 34+00
Box Q 30' Lt

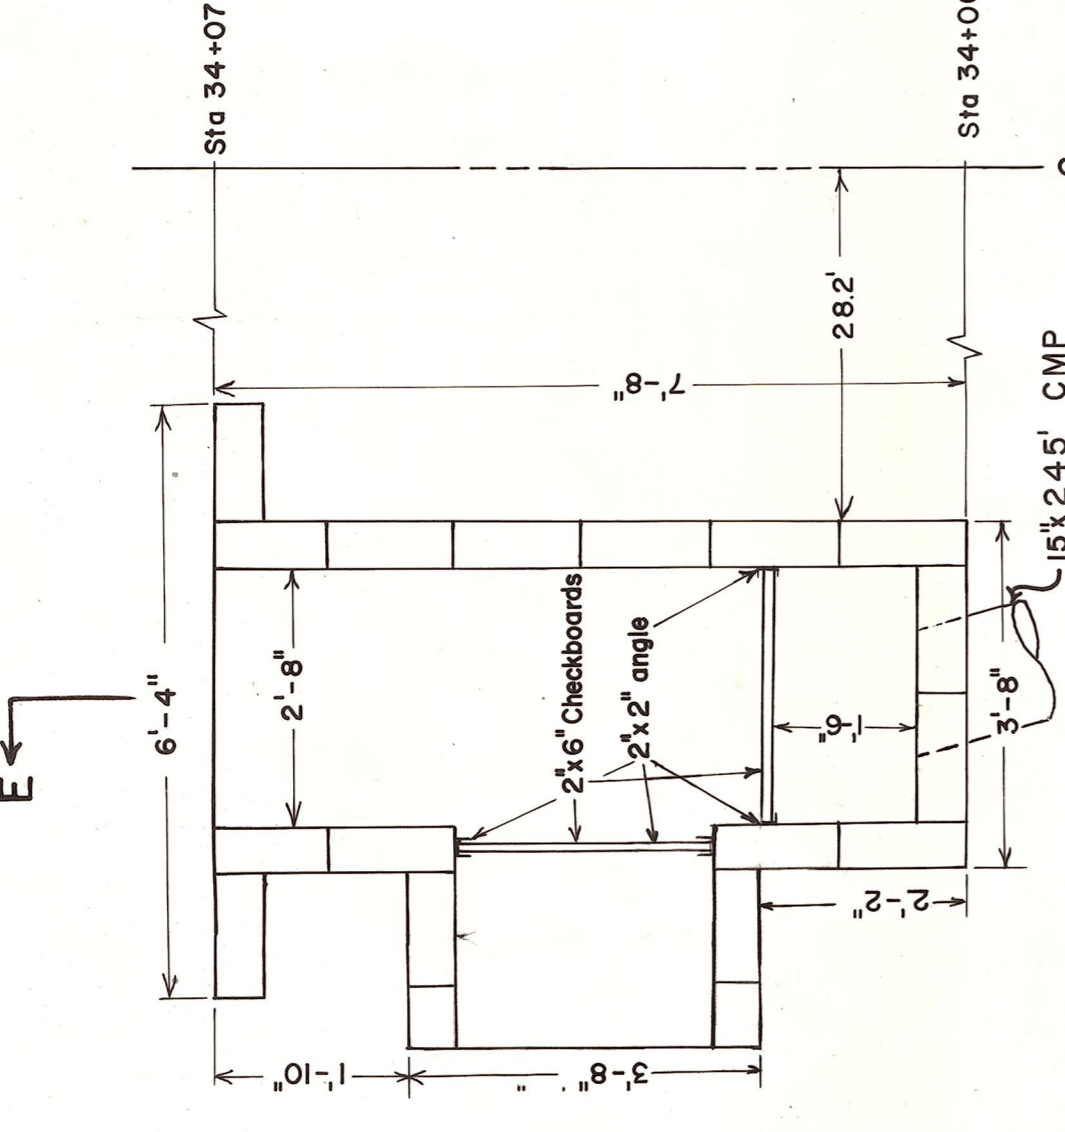

PLAN
Scale 1"=2'

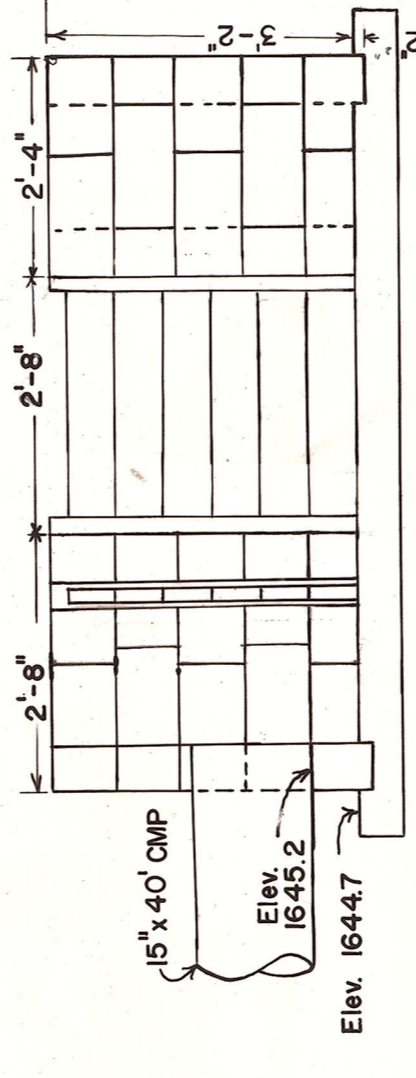


Section E-E
Scale 1"=2'

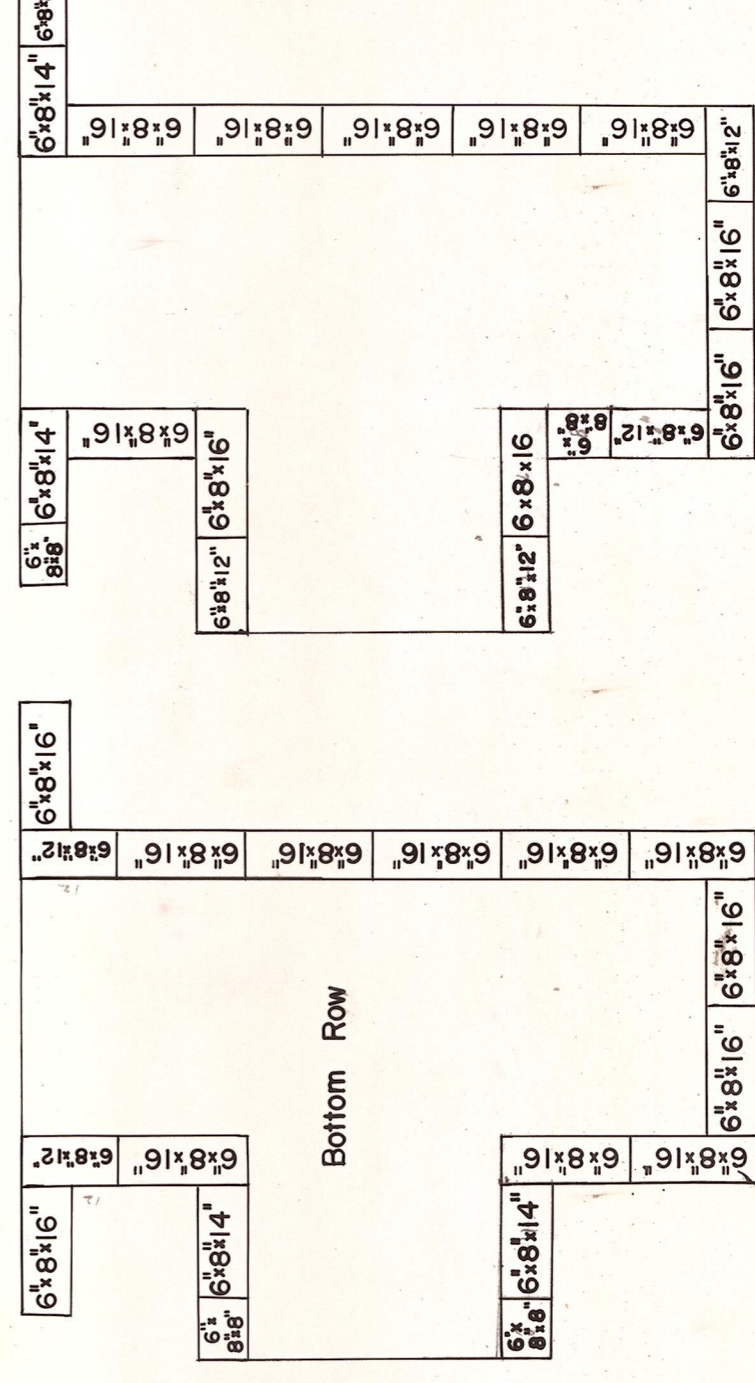


Block Placement Detail


Irrigation Box
Sta 37+25
Box Q 23.8' Lt

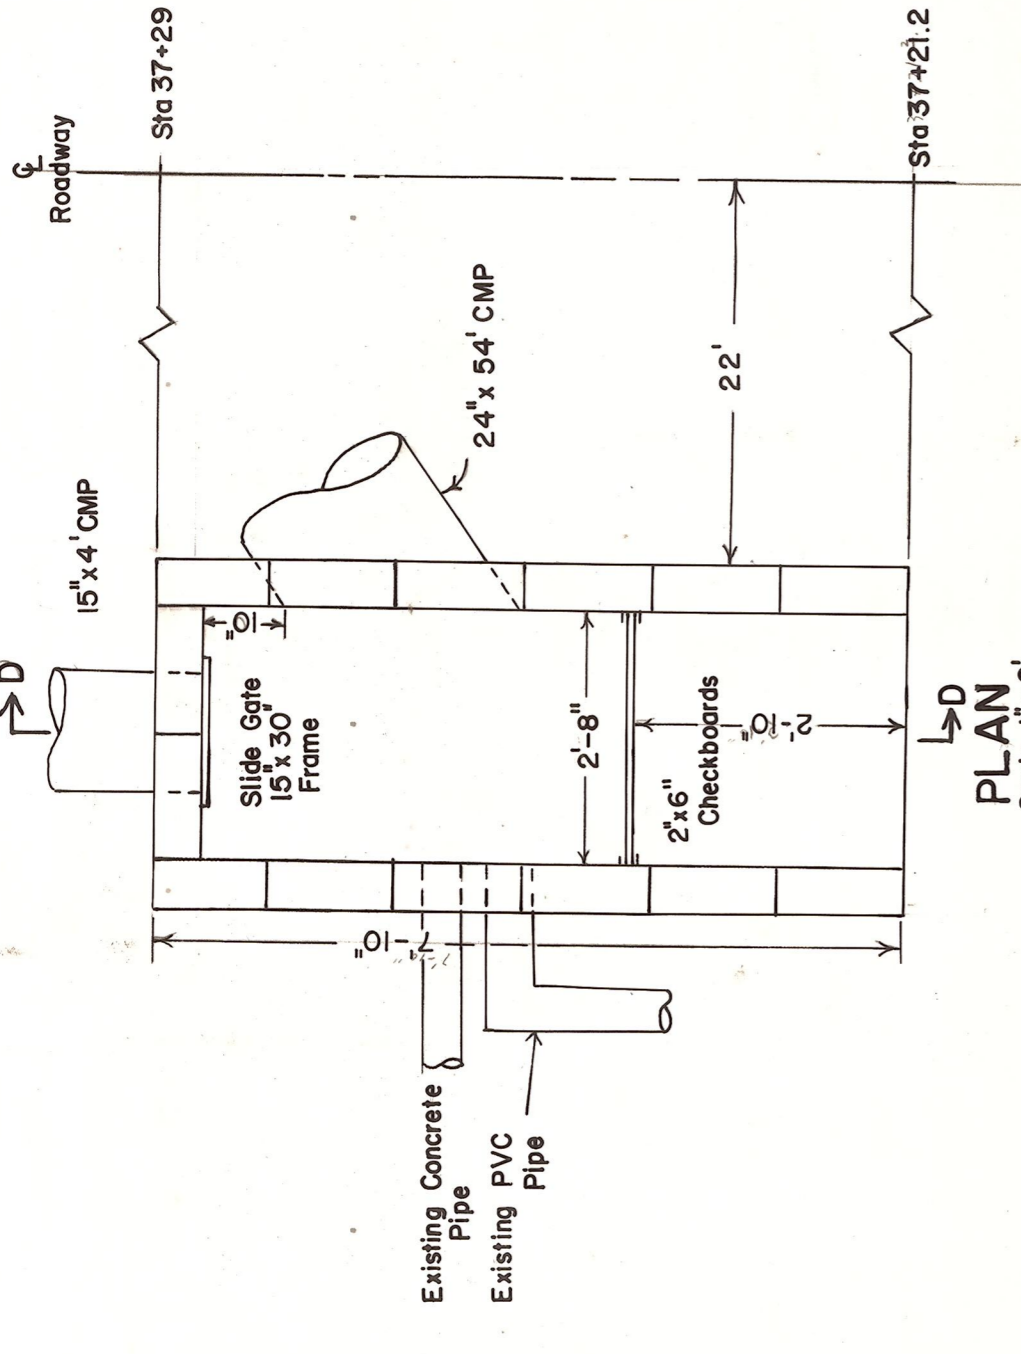

PLAN
Scale 1"=2'

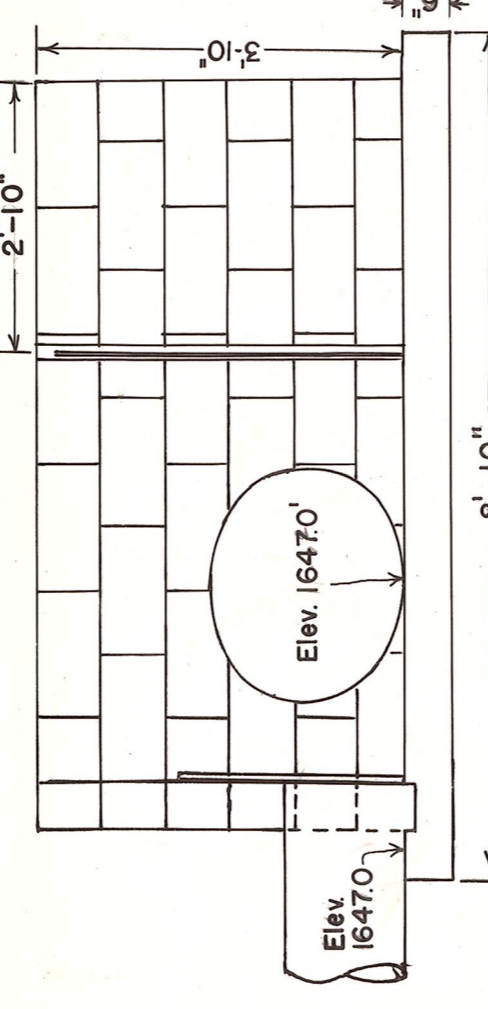

Section D-D

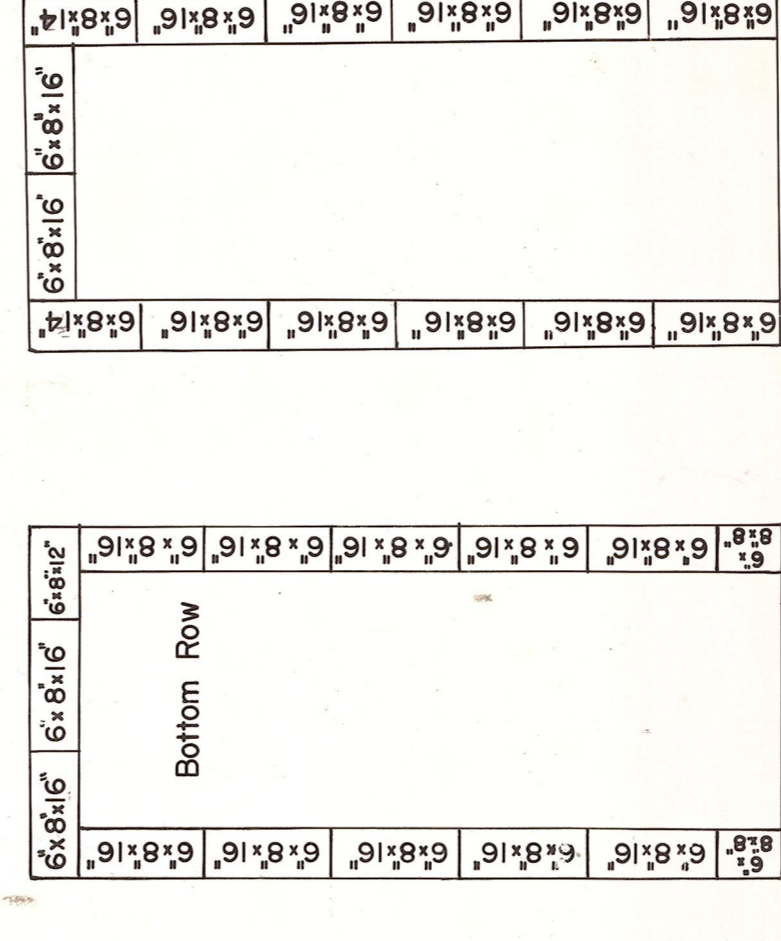

Block Placement Detail

DATE	REVISION	BY
2/4/82	AS BUILT, REVISED PIPE LENGTH BOX 31+10, 31+50, AND 34+00	DWL

KITTITAS COUNTY DEPARTMENT OF PUBLIC WORKS
KITTITAS COUNTY
ELLENSBURG, WASHINGTON
HANSON ROAD

SCALE: H 1"=2'
V 1"=5'

DRAWN BY JLE DATE 3/81

APPROVED:

SHEET 3 OF 3

C R P 24-81

DATE _____ DIRECTOR OF PUBLIC WORKS

Block Quantities

Block Size	Sta 31+10	Sta 31+50	Sta 34+00	Sta 37+25	TOTAL
6'x8 1/2"	98	60	56	72	286
6'x8 1/4"			10	6	16
6'x8 1/8"	14		14	3	31
6'x8 1/16"			12	6	18