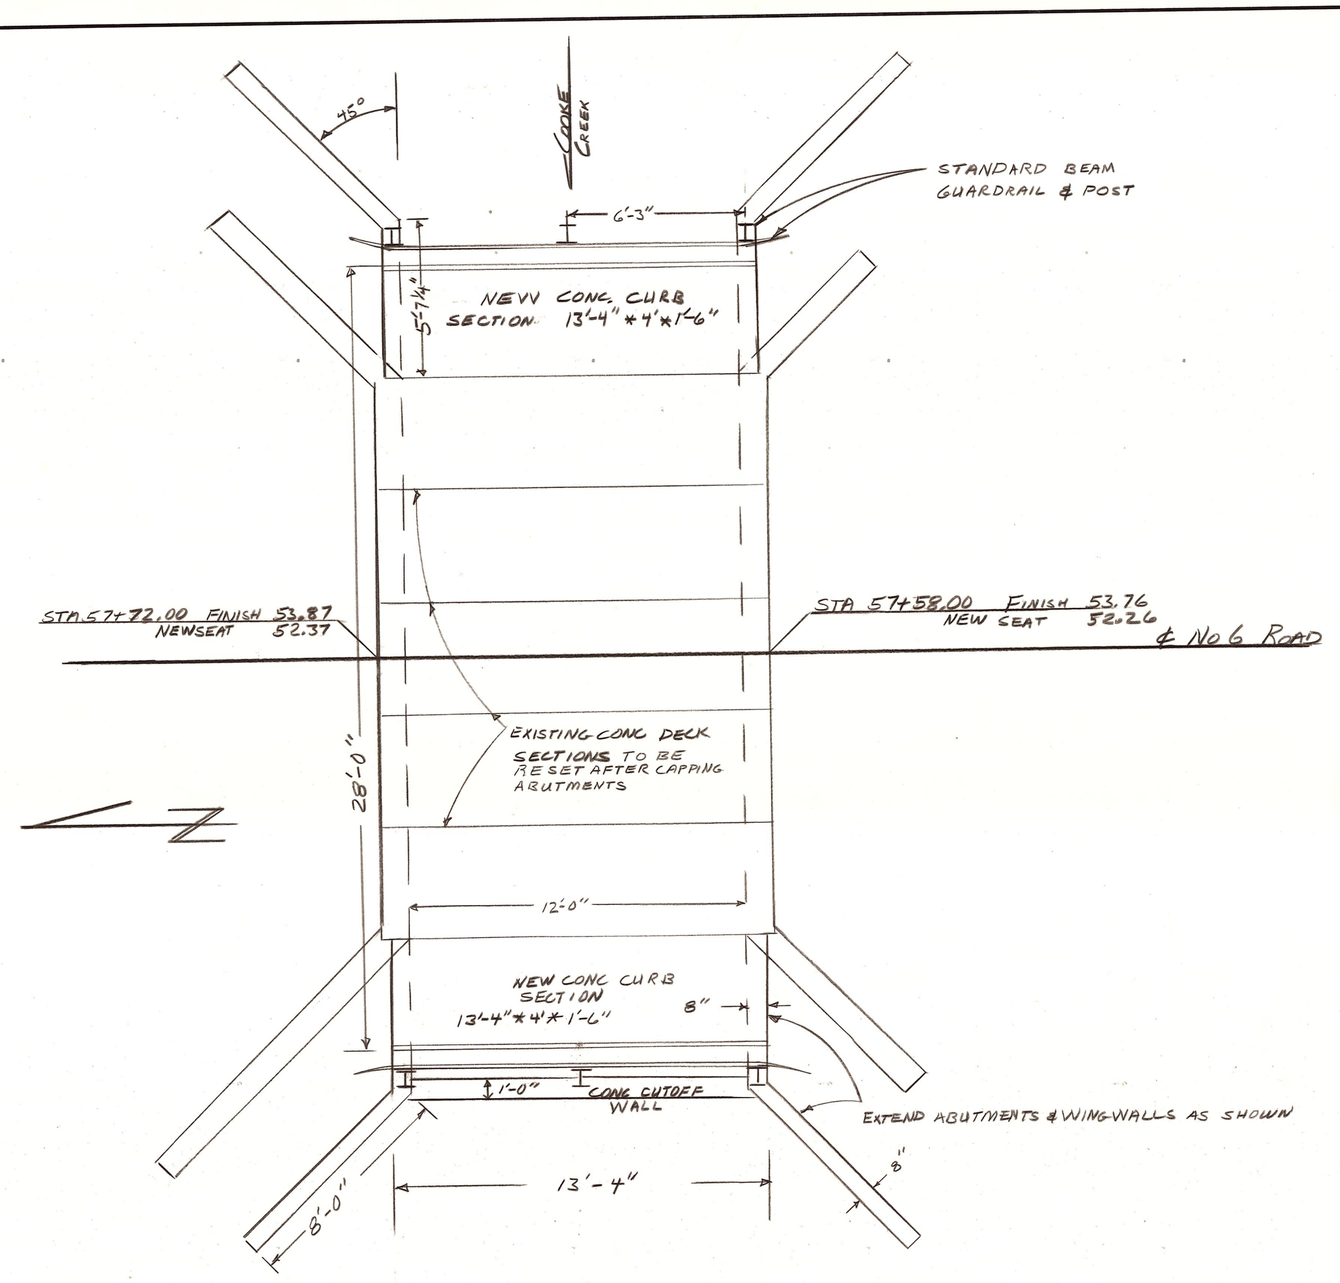

PLAN
SCALE ¼" = 1'-0"

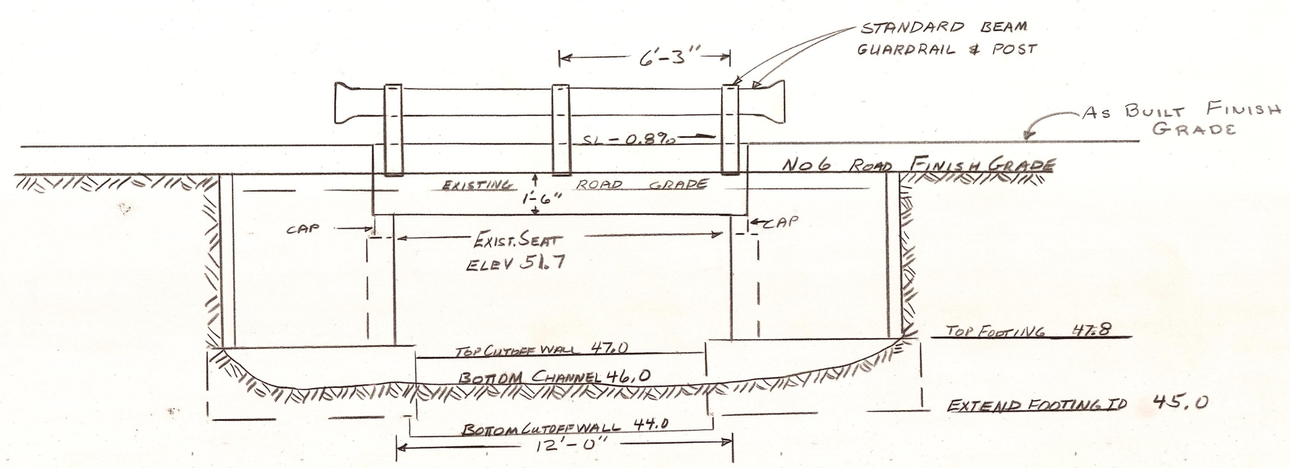

ELEVATION
SCALE ¼" = 1'-0"

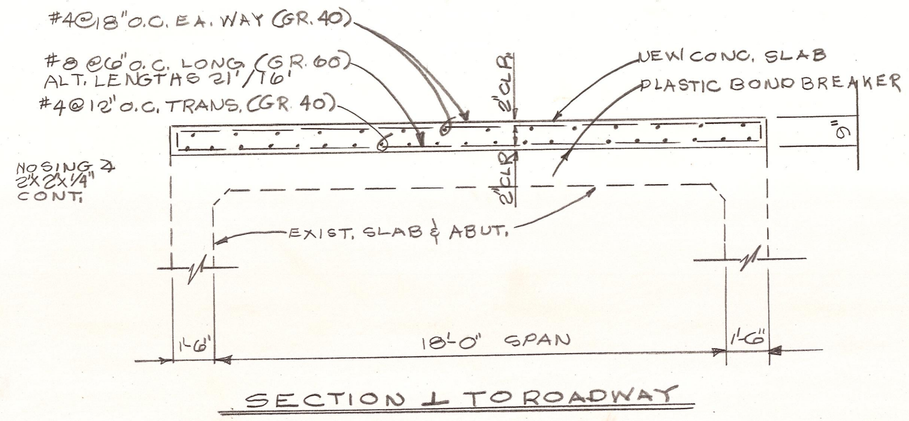

SECTION ⊥ TO ROADWAY

RR	As Built - Finish Grade - Deck Section	12-10-81
BY	REVISION	DATE

OFFICE OF COUNTY ROAD ENGINEER

KITTITAS COUNTY
ELLENSBURG, WASHINGTON

No. 6 Road Bridge # 79202
over ~~Cooke~~ Coleman Creek

SCALE: H AS SHOWN V

CRP 3-77-G

DRAWN BY DJL DATE 8-24-77

SHEET 1 OF 1

APPROVED: 8-26-77 DATE

COUNTY ROAD ENGINEER

GORDON M. PLOSSER REGISTERED PROFESSIONAL ENGINEER STATE OF WASHINGTON