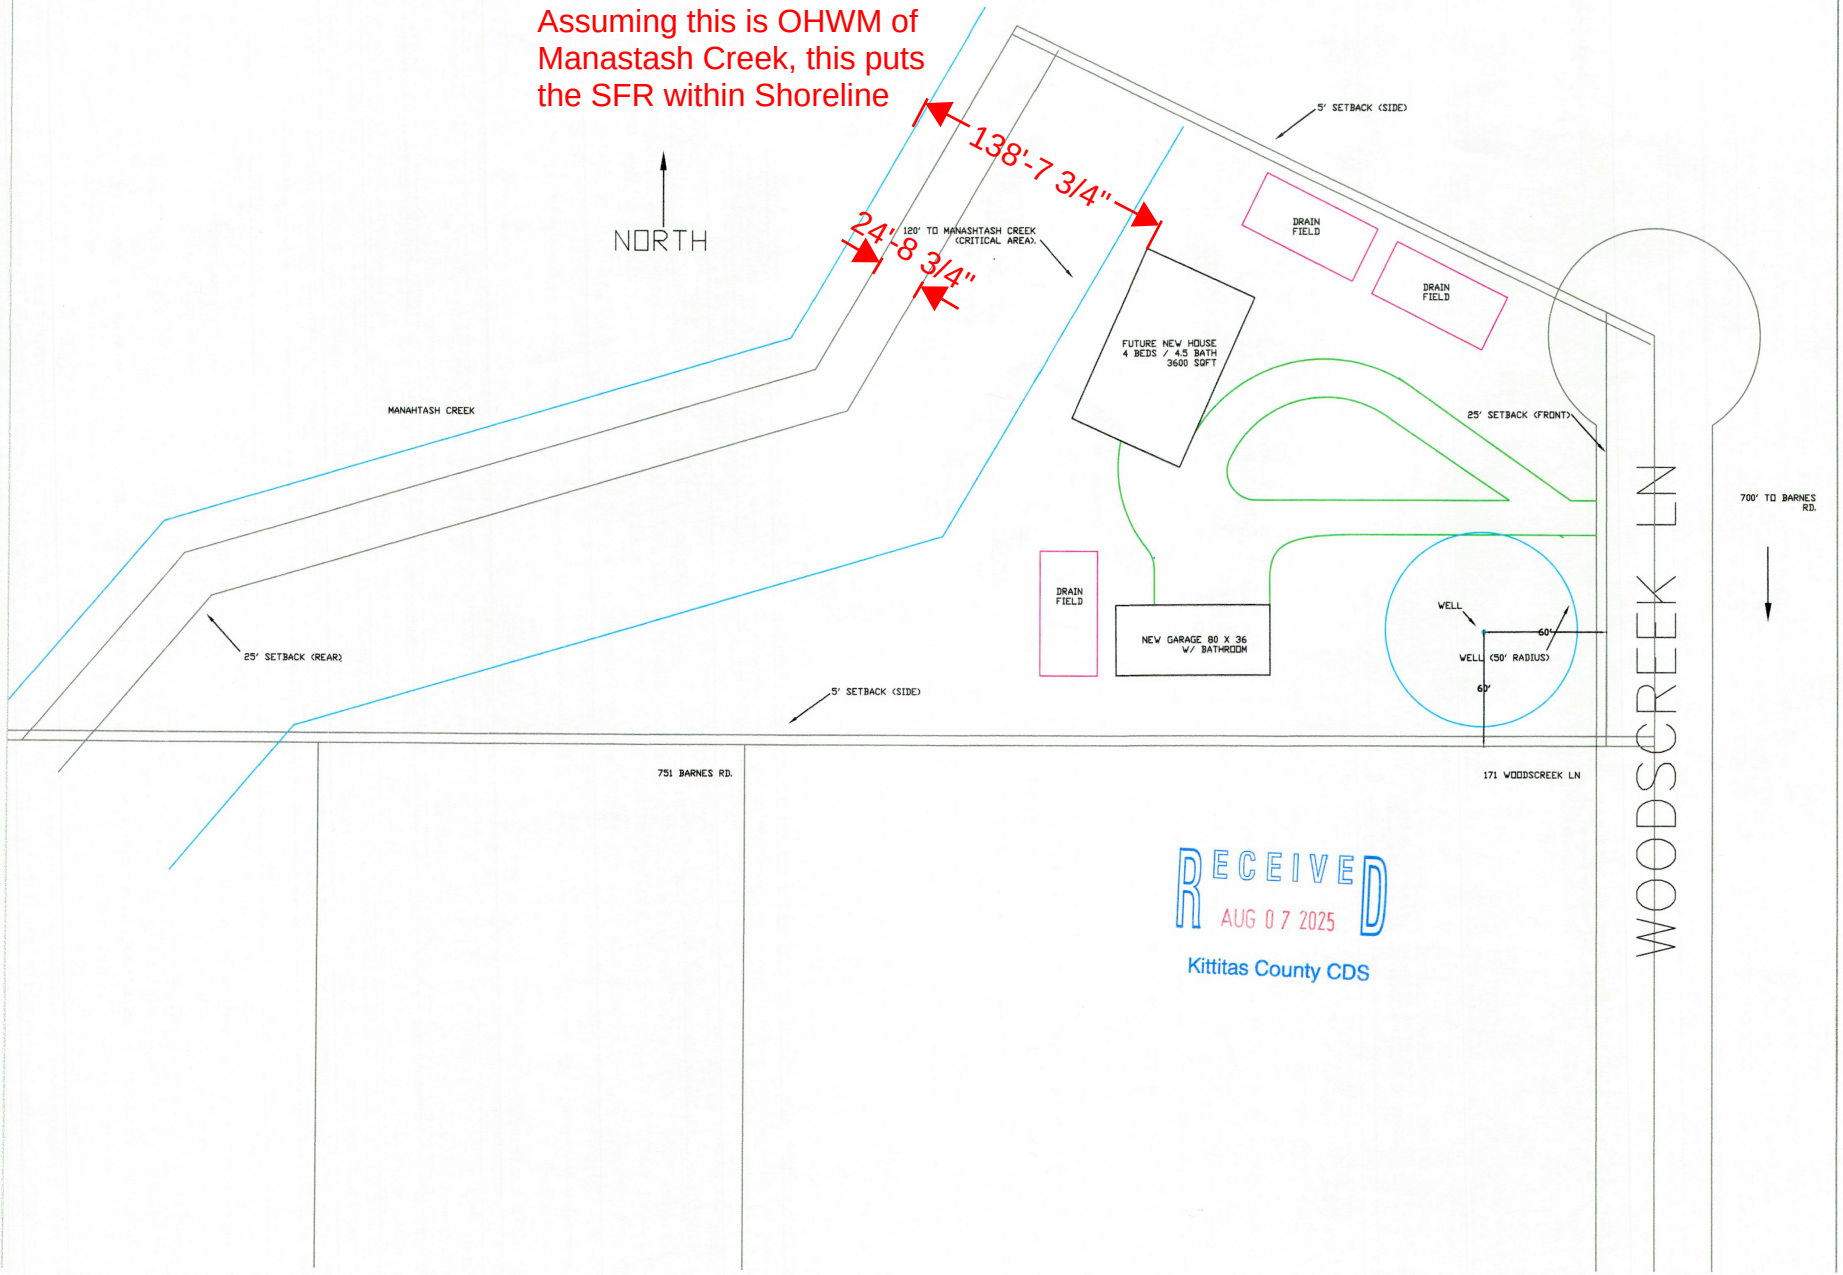

RECEIVED
AUG 07 2025
Kittitas County CDS

REV. 2

ROGERS GARAGE
WOODSCREEK LANE
ELLENSBURG, WA 98926

DATE: 08/06/25

SCALE: 1"=75'

PAGE 1