SEC. 12, T.17N., R.17E., W.M.

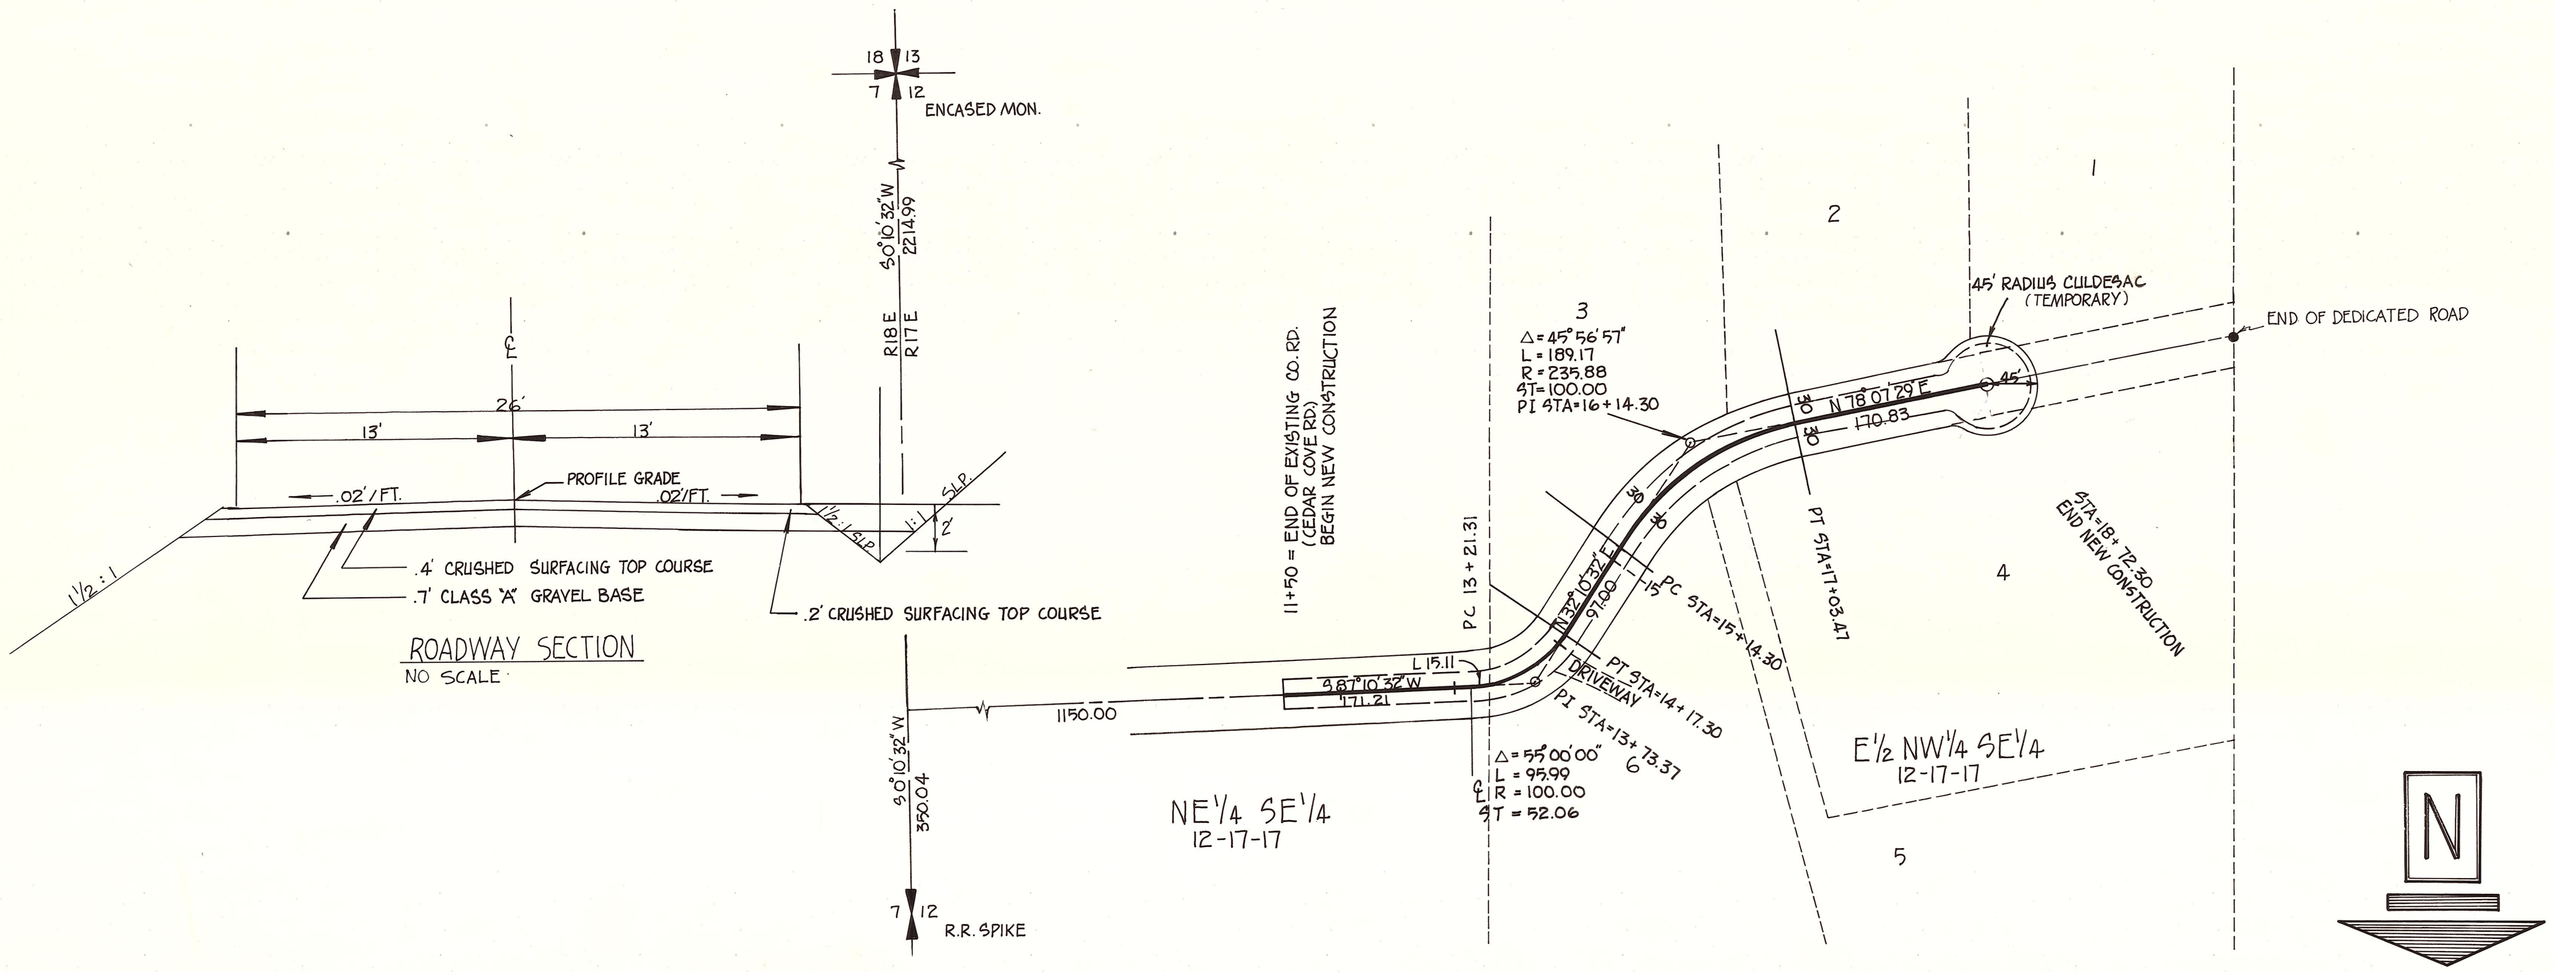

KITTITAS COUNTY
ELLENSBURG, WASHINGTON

CEDAR COVE ROAD

SCALE: H: 1"=100' V: 1"=10'

DRAWN BY: [illegible] DATE: 11/22/77 SHEET 1 OF 1

APPROVED: _____ DATE _____ COUNTY ROAD ENGINEER

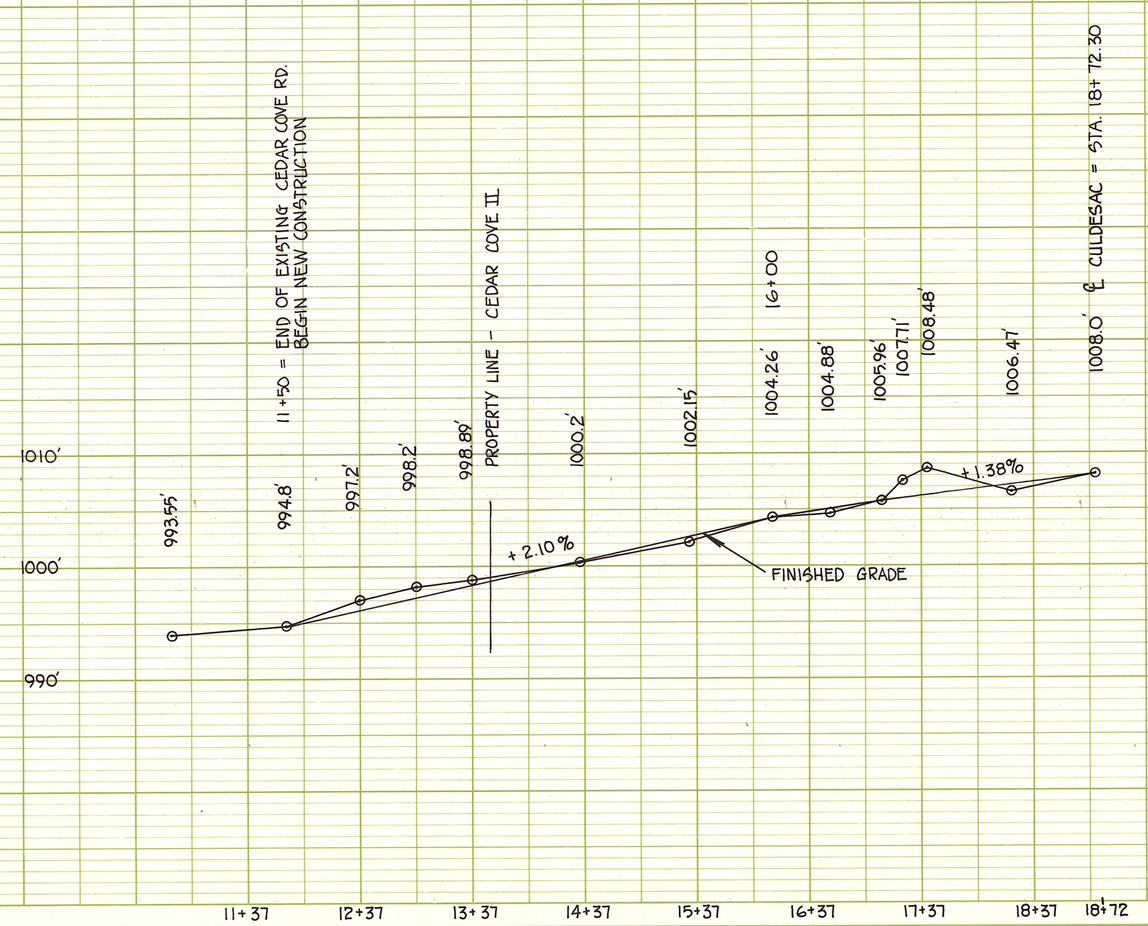

CERTIFICATION

I CERTIFY THAT THIS PLAN AND PROFILE IS BASED ON AN ACTUAL SURVEY IN THE FIELD OF CEDAR COVE ROAD AS BUILT.

JEROLD D. O'HARE
LICENSED LAND SURVEYOR, #9606
DECEMBER 20, 1977

PLATE 1, PLAN-PROFILE
KEUFFEL & ESSER CO.
48 7024 MADE IN U.S.A.

15-16